

# PLAT AND RECORD

Of a Survey on Section 20 T 3 R 13 E. of the 4 P. M. in Harmony Township


Rock County, Wisconsin, made April the 28 1879

I hereby certify that the following is a correct record of said survey as made by me.

COUNTY BUILDING  
IN CITY OF BELOIT

(Signed) Edward Roger  
RAB

County Surveyor.

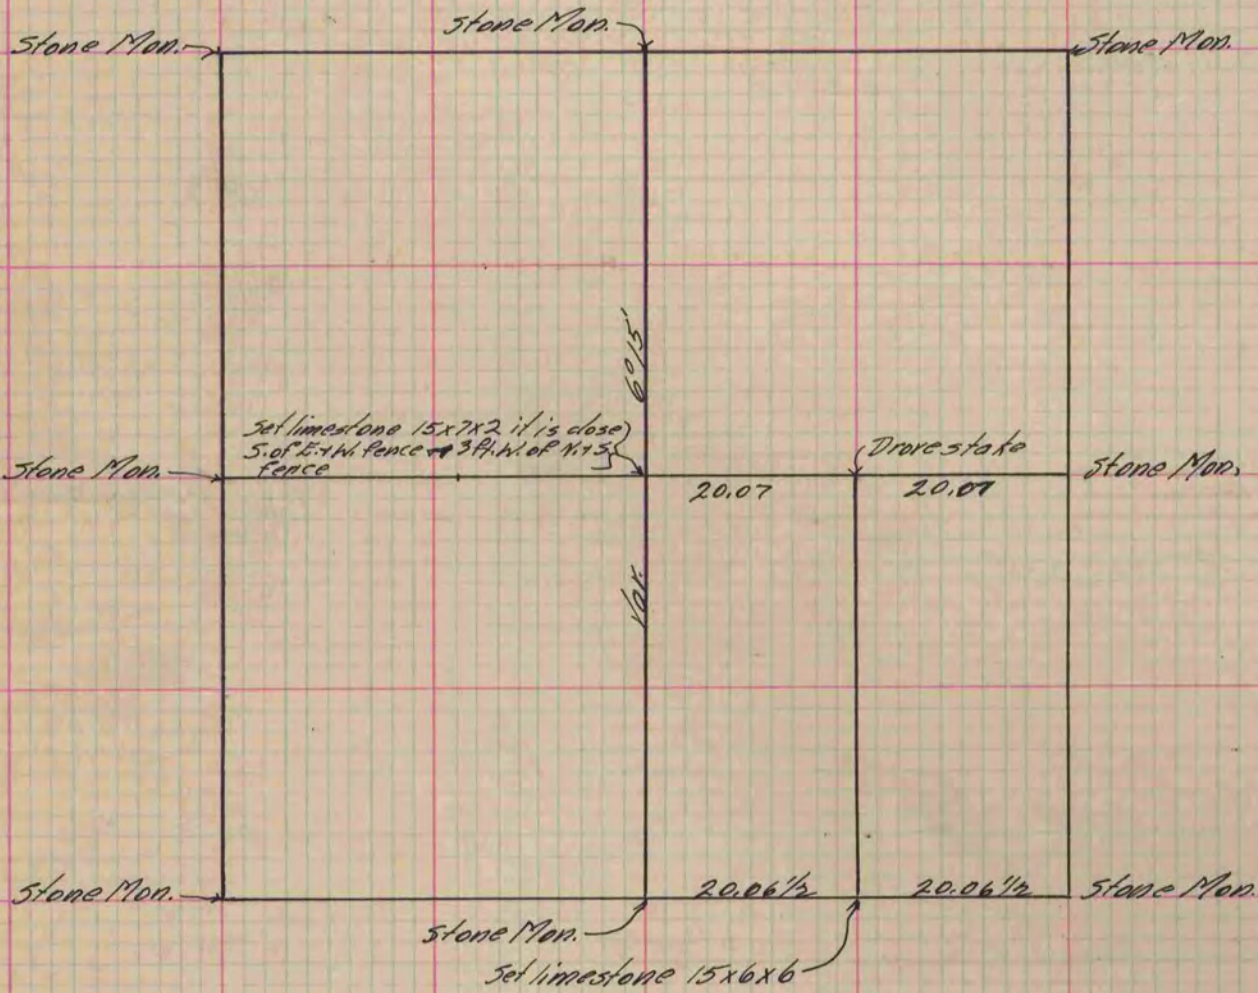

Copied from Lower 1/2 P. 215 Vol. 2 County Surveyor's Record.