

PLAT AND RECORD

Of a Survey on Section 12 T. 1 R. 14 E. of the 4 P. M. in Clinton Township


Rock County, Wisconsin, made April the 26th 1861

I hereby certify that the following is a correct record of said survey as made by me.

COUNTY BUILDING
IN CITY OF BELOIT

(Signed) Edward Ruger.
RMB

County Surveyor.

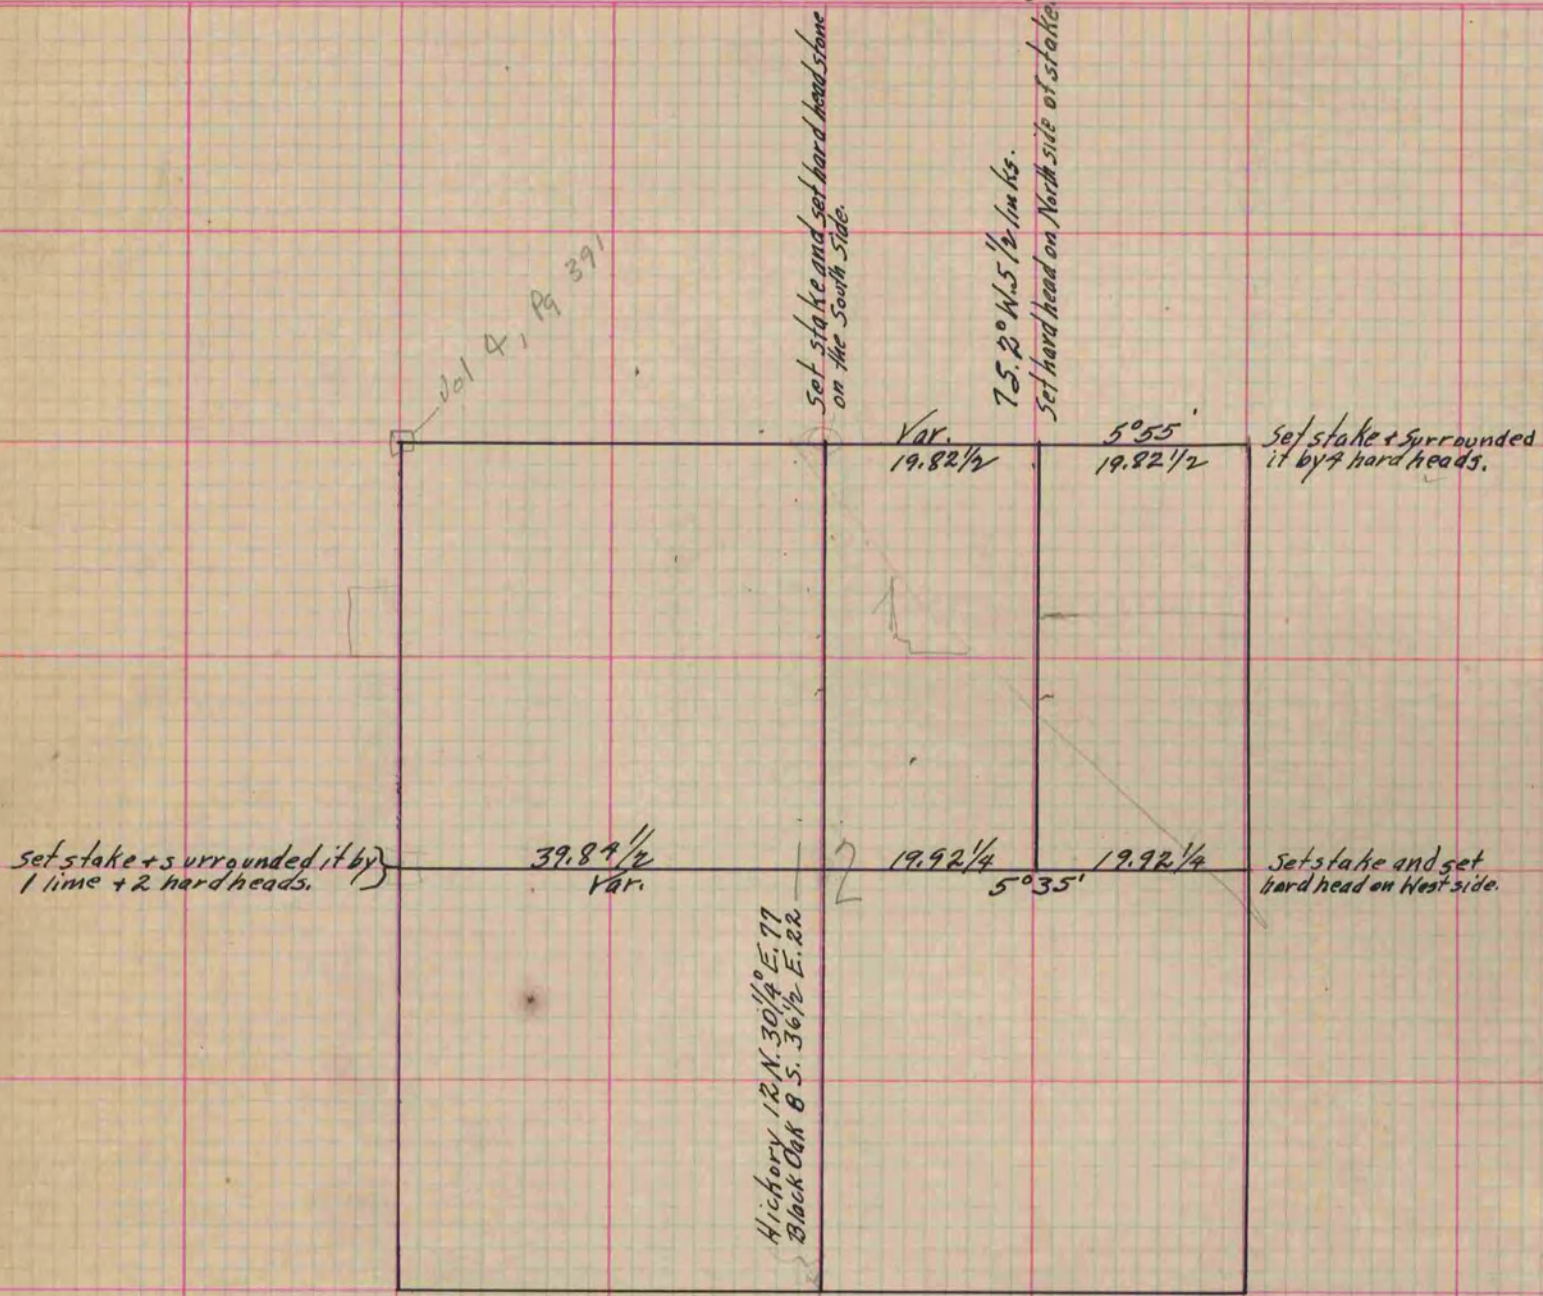

Copied from Page 169 Vol. 1. Original County Surveyors Record.