

PLAT AND RECORD

Of a Survey on Section 23 T 3 R 14 E. of the 4 P. M. in Johnstown Township


Rock County, Wisconsin, made June the 19th 1861

I hereby certify that the following is a correct record of said survey as made by me.

COUNTY BUILDING
IN CITY OF BELOIT

(Signed) Edward Ruger.
ERMB

County Surveyor.

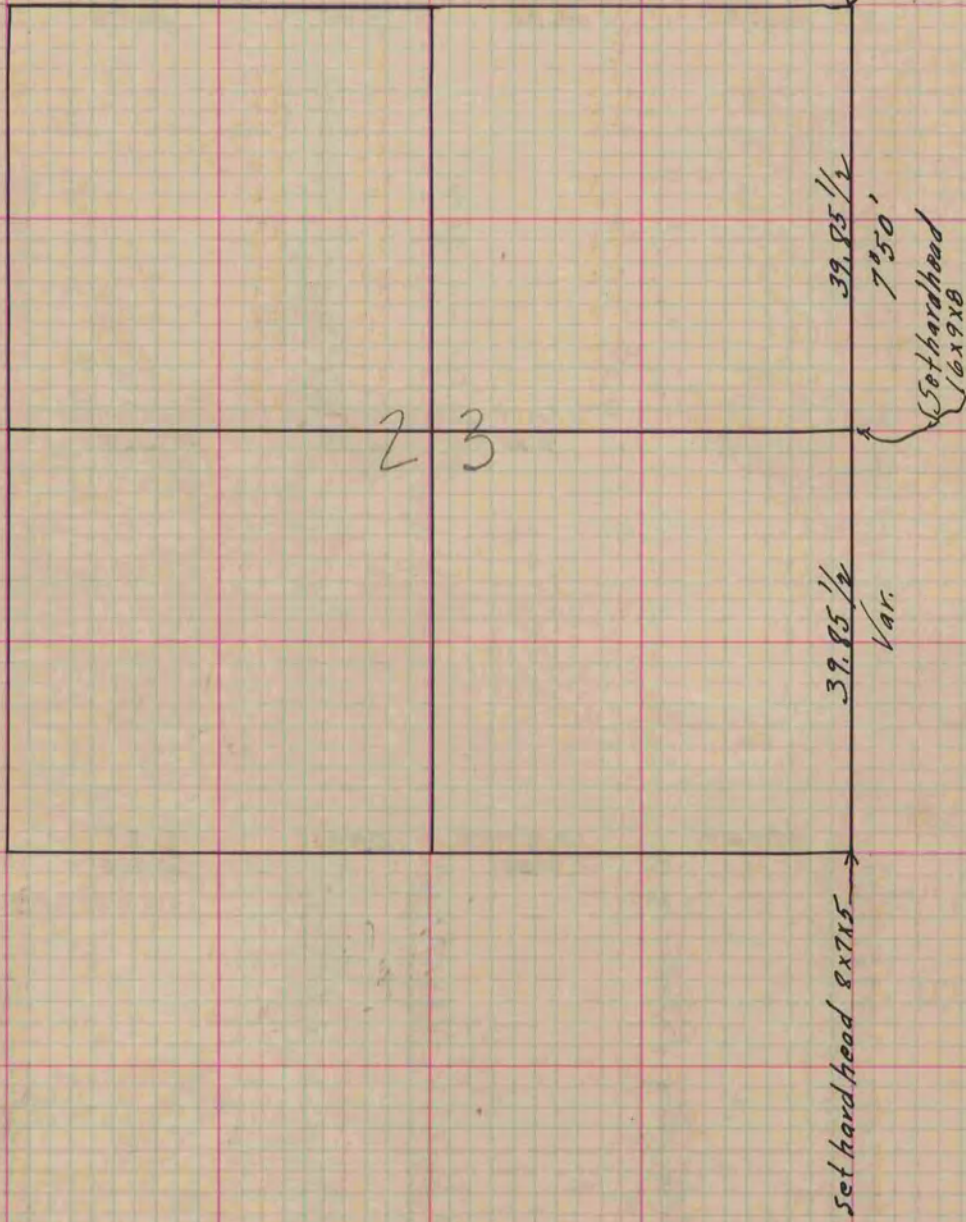

Copied from Page 179 Vol. 1. County Surveyor's Record.