

PLAT AND RECORD

117


Of a Survey on Section 31 T 3 R 13 E. of the 4 P. M. in Harmony Township
Rock County, Wisconsin, made November the 18th 1859

I hereby certify that the following is a correct record of said survey as made by me.

COUNTY BUILDING
IN CITY OF БЕЛОIT

(Signed) Edward Ruger.

County Surveyor.

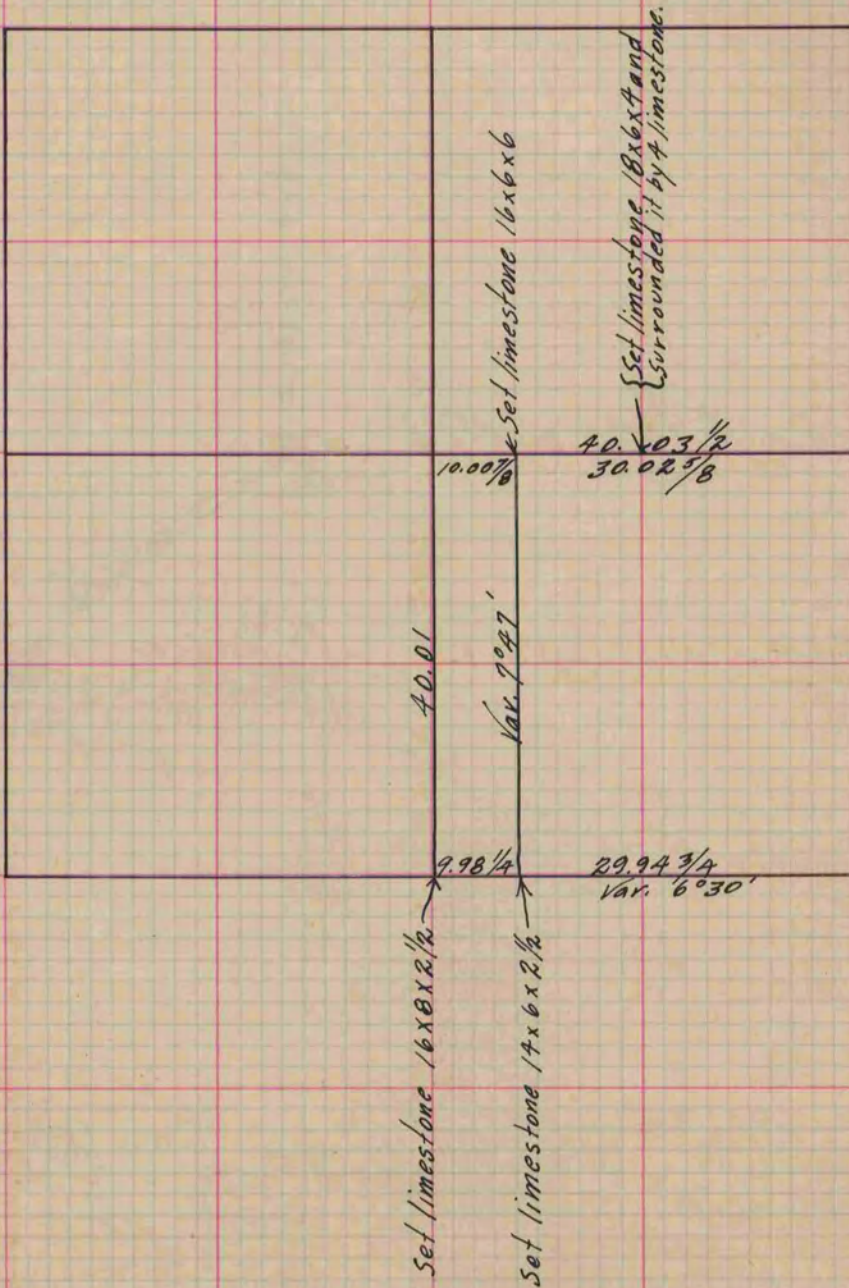

Copied from Page 126 Vol. 1 Original County Surveyor's Record.