

PLAT AND RECORD

Of a Survey on Section 19 T 3 R 14 E. of the 4 P. M. in Johnstown Township


Rock County, Wisconsin, made June the 21st 1861

I hereby certify that the following is a correct record of said survey as made by me.

COUNTY BUILDING
IN CITY OF BELOIT

(Signed) Edward Ruper
ERTB

County Surveyor.

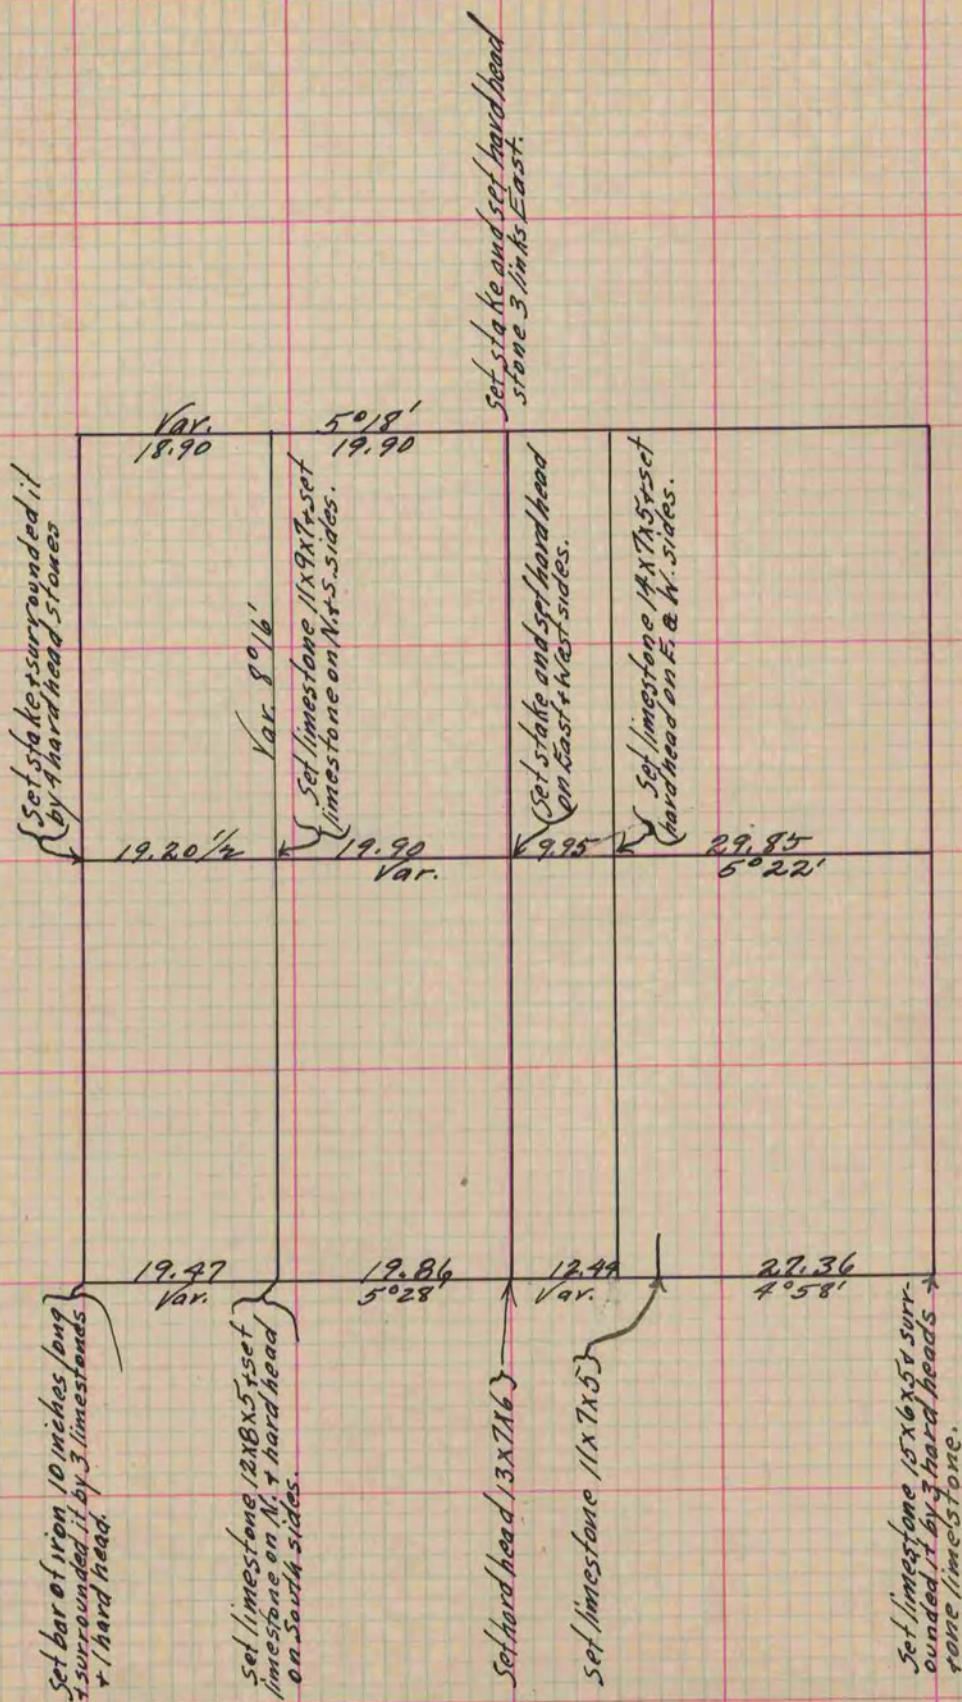

Copied from Page 180 Vol. 1. Original County Surveyor's Record.