


PLAT AND RECORD

Of a Survey on Section 36 T 1 R 13 E. of the 4 P. M. in Turtle Township
 Rock County, Wisconsin, made June the 4th 1859

I hereby certify that the following is a correct record of said survey as made by me.

COUNTY BUILDING
 IN CITY OF BELOIT

(Signed) E. F. Hobart Deputy
R. H. B. County Surveyor.

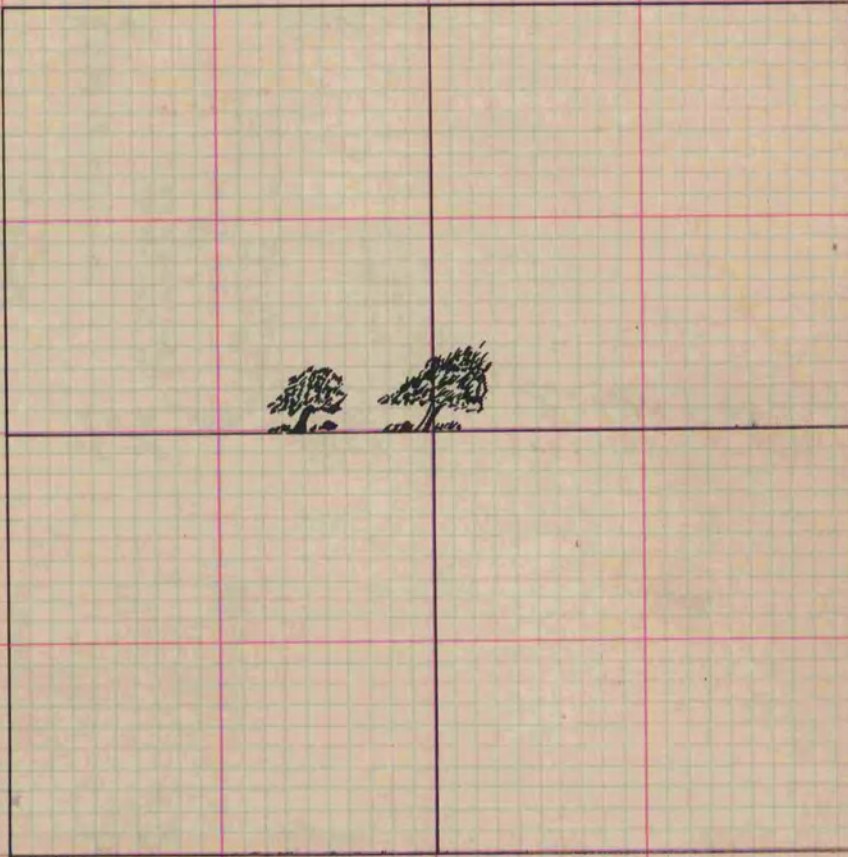

The E. & W. Qr. line at a point 2433 links E. of W. Qr. post is one foot
 S. of Centre of a Br. O. 16 inches in diameter.
 E. & W. Qr. line at a point 39.74 E. of W. Qr. Post is 24 1/2 links N.
 of Br. O. 16 inches in diameter.

Copied from Page 118 Vol. 1. Original County Surveyor's Record.