

# PLAT AND RECORD


Of a Survey on Section 18 T 3 R 14 E. of the 4 P. M. in Johnstown Township  
Rock County, Wisconsin, made May the 31 1886

I hereby certify that the following is a correct record of said survey as made by me.

COUNTY BUILDING  
IN CITY OF БЕЛОIT

(Signed) *Edward Ruger*  
RMR

County Surveyor.

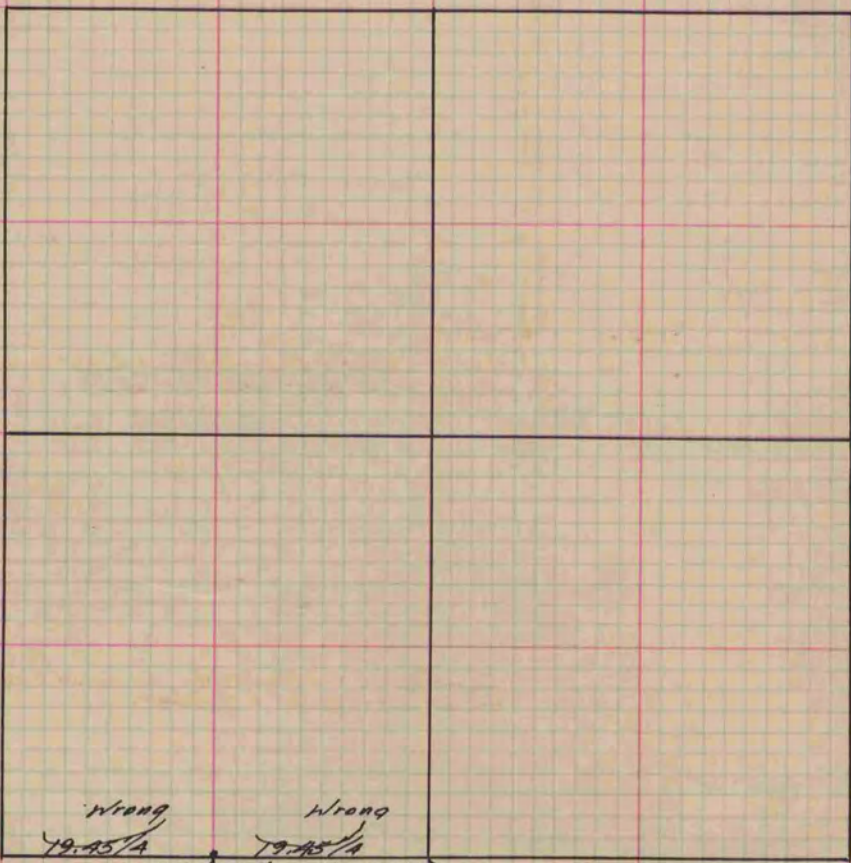

Found old stake, large head stone 3 lks. E. as set in former survey also S.E. B.T. & stump of N.W. B.T. Drove new stake in place of old one & put N.W. close to stake on E. side.

Drove new stake in place of old one by 3 H. Hs. & limestone

Copied from P. 230 Vol. 7 County Surveyor's Record.