
U.S. PUBLIC LAND SURVEY MONUMENT RECORD

For Public Land Survey Corners In: WI ADMINISTRATIVE CODE A-E 7.08 REQUIREMENT T. $\frac{4}{2}$ N. R. $\frac{12}{2}$ E. 4th P.M.

CORNER CODE INDEX

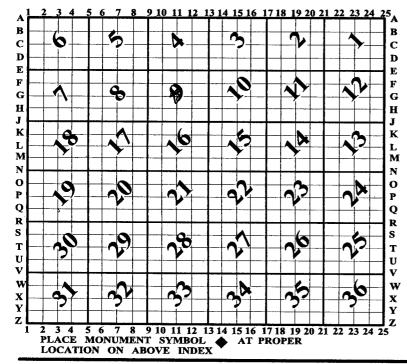

FULTON TWP ROCK COUNTY WI

IF AVAILABLE ROCK COUNTY COORDINATES PERFERRED

North _____ Elev. ____

Hor. Datum _____ Vert. Datum ____

LATITUDE _____ ELLIPS. HT.

LONGITUDE

NAD83(91) _____NETWORK ADJ. YR____

TRAVERSE (X)

BASED ON THE FOLLOWING CONTROL:

♦ CORNER MONUMENT

O WITNESS MONUMENT

GPS (X) ____

BEARINGS ARE BASED ON:

(a)

FIELD BOOK _____ PAGE # ____ SHEET ___ OF ____ SHOW A PLAN VIEW DRAWING DEPICTING THE CORNER MONUMENT AND SURROUNDING PHYSICAL FEATURES, INCLUDING THE EXCAVATION AREA AND DEPTH.
PLANNING & ZONING COMMITTEE ADOPTED THIS FORM ON 12/2/1982

FU4536

- (B) Describe any record evidence, monument evidence, occupational evidence, testimonial evidence or any other material evidence you considered, and whether the monument was found or placed.
- 1857 HOLMES "FASSETT CEMETARY" C-1 PG 20 CALLS FOR "QUARTER POST CENTER SEC 9" IN E/W DRIVE @ BEND TO THE NE.
- 1869 BURDICK "ADDITION TO FASSETT CEMETARY" C-1 PG 2 STAKE @ CENTER OF SEC 9, 328.02 TO A POINT ON THE EAST R/W LINE OF CTH "F" & ON E/W 1/4 LINE. DRAWING SHOWS CORNER IN DRIVEWAY NEAR BEND OF DRIVE TO THE NW.
- 1872 LEE VOL 2 PG 89 ESTABLISHED CENTER BUT STATES NOTHING ABOUT MON. 2664.42 TO E 1/4 COR SEC 9, 2688.18 TO W $^{1/4}$ COR SEC 9, 2649.24 TO S $^{1/4}$ COR SEC 9, 330.66 NORTH OF A LOT COR, 169.62 WEST OF A LOT COR.
- 1891 BLEEDORN VOL 2-450 CALLS FOR CENTER OF SEC BUT STATES NOTHING ABOUT IT.
- 1891 BLEEDORN VOL 2 PG 436 FD COR SET BY LEE SET LS 18X8X6 SURROUNDED BY 3 WH. BR. DRAWING SHOWS CORNER IN CEMETERY.
- 1895 BLEEDORN C-1 PG 24 "THIRD ADDITION TO FASSETT CEMETARY" BEGINNING ON E/W QUARTER LINE AT A POINT 144' EAST OF CENTER SEC 9; THENCE SOUTH AT RIGHT ANGLES TO SAID QUARTER LINE 312'; THENCE EAST PARALLEL TO QUARTER LINE 185.3'; THENCE NORTH PARRALLEL TO THE EAST LINE OF SAID SEC 399.2; THENCE N53 1/2W 498.3 TO THE PUBLIC RD; THENCE SOUTH WESTERN ALONG SAID RD 66.3; THENCE \$53-30E 305.4; THENCE SOUTH 222.0 TO THE PLACE OF BEGINNING.
- 1907 RUGER "FASSETT CEMETARY FOURTH ADDITION" C-1 PG 13 GAS PIPE @ CENTER SECTION EAST 585.82 ALONG E/W 1/4 LINE 585.82 TO IRON ROD, NORTH 260.11 TO GAS PIPE IN CENTER OF DRIVE. [ALSO GAS PIPE ON SOUTH SIDE OF DRIVE]
- 1922 ELY C-1 PG 35 "FASSETT FOURTH ADDITION" CALLS FOR A GAS PIPE @ CENTER OF SEC 9. EAST ALONG 1/4 LINE. 325.51' TO A GAS PIPE. COMMENCING AT THAT GAS PIPE THENCE EAST 585.82' TO A GAS PIPE; THENCE SOUTHERLY [90 ANGLE] 478.5 TO A GAS PIPE; THENCE WESTERLY [90 ANGLE] 260.11 TO A GAS PIPE; THENCE NORTHERLY (90 ANGLE) 478.5 TO THE POB
- 1970 WEIR C-1 PG 57 "5TH ADDITION TO FASSETT CEMETARY" EASTERLY 259.41 ALONG E/W 1/4 LINE TO THE POB.
- 2085.91 TO E $\frac{1}{4}$ COR SEC 9. ?????????? 1981 WEIR C-1 AT END NO PAGE #. "6TH ADD FASSETT" 1" PIPE @ CENTER OF SEC 9, N88-46-41E 840.47 ALONG E/W 1/4 LINE TO A PIPE, S1-40-14E 2648.88 TO S $\frac{1}{4}$ COR SEC 9, 2667.06 TO ALUM MON @ E $\frac{1}{4}$ COR SEC 9
- SANDSNES VOL 6 PG 99 CALLS FOR A IP AND REFERENCED TO CP #3375 AND HEADSTONES. VOID MARKED ON RECORD. CORNER RELOCATED. NOTES NAD27 COORDINATES.
- 1985 SANDSNES G-11 "I HAVE DUG AND FD A 1" DIAMETER IRON PIPE WITH TOP BENT. I RESET A 1"X24" IRON PIPE WHERE THE PIPE STRAIGHENS OUT IN THE GROUND, AND TIED AS SHOWN ABOVE. NAD27 302,245.13; 2,246,374.470.
- 1985 COMBS CSM 12-250 CALLS FOR BUT STATES NOTHING ABOUT CEN OF SEC 9. SOUTH 2161.26 ALONG N/S 1/4 LINE FROM FD IP @ N 1/4 COR SEC 9 TO CENTER OF CTH F.
- COMBS CSM13-72 CALLS FOR IP. SOUTH FROM ALUM AT N $\frac{1}{4}$ COR SEC 9 ALONG $\frac{1}{4}$ LINE 1311.87 TO CENTER OF HAIN RD.
- LATHRUP CSM18-262 IP @ CEN SEC 9, SOUTH 1311.87 1995 FROM ALUM @ N 1/4 COR SEC 9 ALONG 1/4 LINE TO CENTER OF HAIN RD.

SHEET 1 OF

CORNER CODE G-11(2)

Sund Barnes June 12 2006

FU4536

1998 REIGEL G-11(1) FD A 1" IRON PIPE AS CALLED FOR ON CSM VOL 18 PG 262-264 AND SET 4 TIES AS SHOWN.

2002 COMBS CSM 26-25 IP @ CEN SEC 9, FROM ALUM @ N $\frac{1}{4}$ COR SEC 9 SOUTH 1362.14 ALONG N/S 1/4 LINE TO SOUTH R/W LINE OF HAIN RD.

FD 1" IRON PIPE. ABOUT 3' WEST OF THE FD PIPE I FD A N/S WATER LINE ABOUT 6" BELOW PVMT.

NOTE: THE EARLY CEMETERAY PLATS REFLECT MANY DRASTIC REPLATING AND RELOCATION OF DRIVES.

C) Was the corner restored through acceptance of (1) an obliterated evidence location, or, (2) a found perpetuated location?

IN 1985 SANDSNES FOUND A BENT PIPE WHICH APPEARS TO PERPETUATE THE CENTER OF SECTION 9.

- D) Describe any material discrepancy between the location of the corner as restored or reestablished and the location of that corner as previously restored or reestablished by distance and direction. Show the discrepancy on the plan view drawing under (a), above. Show the distances between the corner as previously restored or reestablished and (1) the corner as restored or reestablished, and (2) to at least 4 of the witness monuments shown on the drawing in (a), above.
- (E) Was the corner reestablished through lost corner proportionate methods? If so, show the method, including the directions and distances to other public land survey corners used as evidence or used for proportioning the corner location.
- I, Donald Barnes, hereby certify that the corner location as identified by the corner code index was determined by me under my direction and control and that this U.S. Public Land Survey Monument Record is correct and complete to the best of my knowledge and belief.

Seal

SHEET 2 OF

Emboss

CORNER CODE G-11(2)

A.E. 7.08 REQUIREMENT

| | ZEC 3 E 1/4 COB | 1981 WEIR 2667.06 1977 SANDSNES NAD27 N88-46-41E 2667.02 2005 FAVORITE 1333.16 1995 LATHROP 2666.42 1993 KREBS 2666.32 1891 BLEEDORN VARG-20 2664.42 1872 LEE VAR8 2664.42 | |
|------------------------------------------------------------------------------------------------------------|--------------------|----------------------------------------------------------------------------------------------------------------------------------------------------------------------------|--------------------------------|
| MO0-59-02W 2662,79 1997 KREBS 2663,10 1994 KREBS 2663,11 1994 KREBS 2663,10 1997 KREBS 2663,10 | 1977 SANDSNES 1 | NI-0S-14M S648'64 21-0S-47E S649.84 31-02-47E S649.84 1872 LEE S649.24 | |
| SEC 9 COR | CENTER OF SEC 9 | 1872 LEE VAR8 2 NAD27 N88-48-26E 2 N89-24-47E 2 | S 1/4 COR SEC 9 ED SQUARE L.S. |
| | NOO E /T M | 54007 3 0 54007 3 0 54007 3 0 54007 3 0 | (2) |

