
## U.S.

BEARINGS ARE BASED ON:

## SURVEY TUBLIC MONUMENT RECORD

For Public Land Survey Corners in the T. LN., R. 13 E

CORNER CODE INDEX

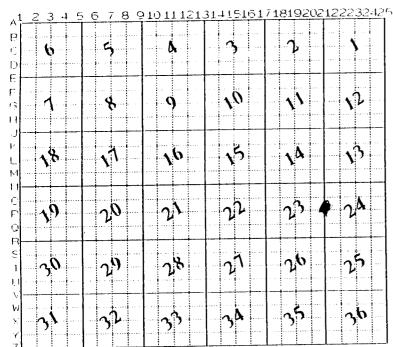

TU	2TLE	TW	ı
ROCK	COUNTY	W1	

IF AVAILABLE ROCK COUNTY COORDINATES PERFERRED

North 2/3,787.67 Elev. East 5 22,6/6,24

Hor. Datum <u>COONTY</u> Vert. Datum \_

TRAVERSE (X) X GPS (X) BASED OF THE FOLLOWING CONTROL:

PLACE MONUMENT SYMBOL & LOCATION ON ABOVE INDEX

CORNER MONUMENT (a)

TIES IN P21

O WITHESS MONUMENT

FIELD BOOK PAGE #

SHOW A PLAN VIEW DRAWING DEPICTING THE COTIEN MOLDENT AND SUPPOLIZOTING THIS CALL FEATURES, INCLUDING THE EXCAVATION AREA AND DEPTH. THE COTIEN MOLDENT AND SUPPOLIZOTING THE COTIEN MOLDENT AND SUPPOLIZOTING PHYSICAL FEATURES, INCLUDING THE EXCAVATION AREA AND DEPTH. THE COTIEN MOLDENT SHALL HAVE BEFORE THE FOLLOWING CHARACTERISTICS: 1) HAVE A LEAST TWO PREDICTIONS COUNTS SINKEY HOUSELFT - FEHALLY FOR DISTINGUISMENT: 5) OR AN EXISTING CILL TRESIDEE. AN INTERESTICAL AND AND THE CAP IS DISCONLED THOSE COUNTS SINKEY HOUSEHOLD OF THE SUPPLIES. INCLUDING MARKETS: 5) OR AN EXISTING CILL TRESIDED CARRESTO AND AND THE CAP IS DISCONLED TOOKS COUNTS SINKEY HOUSEHOLD OF THE SUPPLIES TO THE COTIEN BY AN INFRINCENCE BRANCHES SHALL BE HEREOGRAPH AND THE SECOND THE SUPPLIES MONOMERS SHALL BE HEREOGRAPH AND THE COTIEN AND THE MARKETS MONOMERS SHALL BE HARD CHARGE OF COMPANY OF THE COTIEN SHALL BE HARD THE COTIEN AND THE COTIEN SHALL BE HARD THE COTIEN AND THE MARKETS MONOMERS SHALL BE HARD THE COTIEN AND THE MARKETS MONOMERS SHALL BE HARD THE COTIEN AND THE MARKETS MONOMERS SHALL BE HARD THE COTIEN AND THE COTIEN AND THE MARKETS MONOMERS SHALL BE HARD THE COTIEN AND THE COTIEN AND THE MARKETS MONOMERS SHALL BE HARD THE COTIEN AND THE MARKETS MONOMERS SHALL BE HARD THE COTIEN AND THE COTIEN AND THE MARKETS MONOMERS SHALL BE HARD THE COTIEN AND THE COTIEN AND THE MARKETS MONOMERS SHALL BE HARD THE COTIEN AND THE COTIEN AND THE MARKETS MONOMERS SHALL BE HARD THE COTIEN AND THE COTIEN AND THE MARKETS MONOMERS SHALL BE HARD THE COTIEN AND THE MARKETS MONOMERS SHALL BE COTIEN AND THE COTIEN AND THE MARKETS MONOMERS SHALL BE COTIEN AND THE COTIEN AND THE MARKETS MONOMERS SHALL BE COTIEN AND THE MARKETS MONOMERS SHALL BE COTIEN AND THE MARKETS MONOMERS SHALL BE COTIEN AND THE COTIEN AND THE MARKETS MONOMERS SHALL BE COTIEN AND THE MARKETS MONOMERS.

PLAINING & ZOMING COMMITTEE ADOPTED THE ABOVE FORM ON 12/2/1995 WI ADMINISTRATIVE CODE A-E 7.08 REQUIRENEIS

SHEET \_\_\_\_OF

PZ1(1)

- (B) Describe any record evidence, monument evidence, occupational evidence, testimonial evidence or any other material evidence you considered, and whether the monument was found or placed.
- considered, and whether the monument was found or placed.

  1867 LOCKE VOL 1 PG 283 FOUND STUMP OF SOUTH BT & OLD STAKE SET BUR OAK STAKE 5308.25 TO E 1/4 COR SEC 24.
- 1869 LEE VOL 1 PG 350 FOUND CORNER SET BY LOCKE 2645.94 VAR 6-45 TO SW COR SEC 24.
- 1876 RUGER VOL 2 PG 215 FOUND OLD STAKE & DECAYED STUMPS OF BOTH BTS DROVE NEW STAKE IN THE PLACE OF THE OLD ONE & PUT HH STONE ON THE N&S SIDES. 2653.2 TO CENTER OF SEC 24,2645.94 TO SW COR SEC 24,2647.92 VAR 5-45 TO NW COR SEC 24.
- 1970 BATTERMAN VOL 4 PG 433
- 1985 BARNES P21 FOUND CAST IRON MON. & REFERENCED SAME.

FOUND CAST IRON MON. & REFERENCE PIPES.

- C) Was the corner restored through acceptance of (1) an obliterated evidence location, or, (2) a found perpetuated location?
  ACCEPTED FOUND PERPETUATED LOCATION.
- D) Describe any material discrepancy between the location of the corner as restored or reestablished and the location of that corner as previously restored or reestablished by distance and direction. Show the discrepancy on the plan view drawing under (a), above. Show the distances between the corner as previously restored or reestablished and (1) the corner as restored or reestablished, and (2) to at least 4 of the witness monuments shown on the drawing in (a), above.
- (E) Was the corner reestablished through lost corner proportionate methods? If so, show the method, including the directions and distances to other public land survey corners used as evidence or used for proportioning the corner location.

I, Donald Barnes, hereby certify that the corner points as identified by the corner code index were, in a field survey on,1994, established, re-established, monumented, re-monumented, recovered or restored as expressed below and in conformance with the regulations and rules as required in the current manual of survey instructions of the United States Department of Interior, Bureau of Land Management.

COUNTY SURVEYOR FILING DATA

Date of computer entry\_\_\_\_

Date microfilmed \_\_\_\_\_

Number of included sheets \_\_\_ CORNER CODE

A-E 7.08 REQUIREMENT

EMBOSS LAND SURVEYOR SEAL

Onold Bains

P2/(1)