

# PUBLIC LAND SURVEY MONUMENT RECORD

For Public Land Survey Corners in the


T. 1 N., R. 13 E

## CORNER CODE INDEX

	1	2	3	4	5	6	7	8	9	10	11	12	13	14	15	16	17	18	19	20	21	22	23	24	25
A																									
B																									
C																									
D																									
E																									
F																									
G																									
H																									
I																									
J																									
K																									
L																									
M																									
N																									
O																									
P																									
Q																									
R																									
S																									
T																									
U																									
V																									
W																									
X																									
Y																									

PLACE MONUMENT SYMBOL (●) AT PROPER LOCATION ON ABOVE INDEX

### EXAMPLE

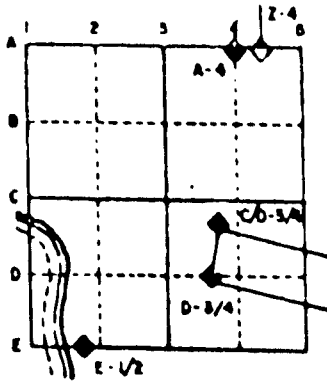

TURTLE TWP  
ROCK COUNTY WI

IF AVAILABLE  
STATE PLANE COORDINATES

North (Y) 216,435.02 Elev. (Z) \_\_\_\_\_  
 East (X) 522,614.65 Zone \_\_\_\_\_  
 Hor. Datum COUNTY Vert. Datum \_\_\_\_\_

◆ CORNER MONUMENT

○ WITNESS MONUMENT

*Fd ALUM MON*

*Fd TIES IN N21*

BEARINGS ARE BASED ON:

SHEET \_\_\_ OF \_\_\_

N21(1)  
CORNER CODE:

(B) Describe any record evidence, monument evidence, occupational evidence, testimonial evidence or any other material evidence you considered, and whether the monument was found or placed.

- 1842 TERRITORIAL ROAD RECORDS VOL 6 PG 331 ROAD BENDS TO THE WEST AT 167.64' SOUTH OF THE CORNER.
- 1876 RUGER VOL 2 PG 215 FOUND STUMP OF NE BT & REMAINS OF OLD STAKE. STUMP OF SW BT WASHED OUT. SET LS 24X9X8 2664.42 VAR 4-15 TO N 1/4 COR SEC 24, 2647.92 VAR 5-45 TO W 1/4 COR SEC 24.
- 1914 HH MON 2660 TO W 1/4 COR SEC 13.
- 1971 LEE VOL 4 PG 548 FOUND NOTHING SET ALUM BY PRORATION & REFERENCED CORNER. 2661.24 TO S 1/4 COR SEC 14 & 2663.16 TO E 1/4 COR SEC 14.
- 1985 BARNES N21 FOUND ALUM MON.

FOUND ALUM. MON. & REFERENCE TIES IN N21. 2664.98 (REC 2664.42) TO N 1/4 COR SEC 24, 2647.34 (REC 2647.92) TO W 1/4 COR SEC 24, 2660.88 (REC 2661.24) TO S 1/4 COR SEC 14, & 2663.29 (REC 2663.16) TO E 1/4 COR SEC 14.

C) Was the corner restored through acceptance of (1) an obliterated evidence location, or, (2) a found perpetuated location?  
ACCEPTED FOUND PERPETUATED LOCATION.

D) Describe any material discrepancy between the location of the corner as restored or reestablished and the location of that corner as previously restored or reestablished by distance and direction. Show the discrepancy on the plan view drawing under (a), above. Show the distances between the corner as previously restored or reestablished and (1) the corner as restored or reestablished, and (2) to at least 4 of the witness monuments shown on the drawing in (a), above.

(E) Was the corner reestablished through lost corner proportionate methods? If so, show the method, including the directions and distances to other public land survey corners used as evidence or used for proportioning the corner location.  
NO

I, Donald Barnes, hereby certify that the corner points as identified by the corner code index were, in a field survey on, 1994, established, re-established, monumented, re-monumented, recovered or restored as expressed below and in conformance with the regulations and rules as required in the current manual of survey instructions of the United States Department of Interior, Bureau of Land Management.

seal

*Donald Barnes*  
*7/14/95*

COUNTY SURVEYOR FILING DATA

Date of computer entry \_\_\_\_\_

Date microfilmed \_\_\_\_\_

Number of included sheets \_\_\_\_\_  
CORNER CODE

EMBOSS LAND SURVEYOR SEAL

A-E 7.08 REQUIREMENT

N 21 (1)