
U.S. PUBLIC LAND SURVEY MONUMENT RECORD

For Public Land Survey Corners in the T. 3 N., R. // E.

CORNER CODE INDEX

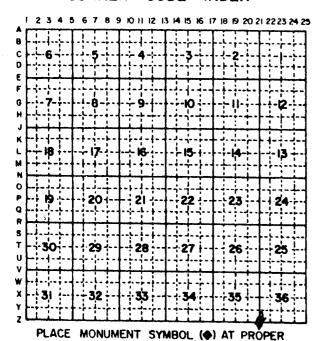

LOCATION ON ABOVE INDEX

ROCK COUNTY W

IF AVAILABLE STATE PLANE COORDINATES

North (Y) Eleve. (Z)
East (X) Zone
Hor. Datum Vert. Datum

,	(Q.)
---	---	----	---

	•	CORNER	MONUMENT
--	---	--------	----------

O WITNESS MONUMENT




MICROFILMED

•		 LAIR	F	
				_

SHOW A PLAN VIEW DRAWING DEPICTING THE CORNER MONUMENT AND SURROUNDING PHYSICAL FEATURES, INCLUDING THE EXCAVATION AREA AND DEPTH. THE CORNER MONUMENT SHALL HAVE THE FOLLOWING CHARACTERISTICS: 1) HAVE AT LEAST TWO PREDETERMINED BREAK-OFF POINTS. 2) IF BROKEN, LEAVE A PERMANENTLY MAGNETIZED REMNANT AT THE ORIGINAL POINT. 3) MUST BE EXTENDABLE. 4) THE CAP IS INSCRIBED: ROCK COUNTY SURVEY MONUMENT - PENALTY FOR DISTURBING MARKER. 5) OR AN EXISTING CUT LIMESTONE. AN IRON PIPE IN A 10" (MINIMUM) MAY BE USED IN AREAS WHERE GHOUND WATER IS WITHIN ONE FOOT OF THE SURFACE. IF THE CORNER IS OCCUPIED BY AN IMPROVEMENT (MANHOLE, BURIED CABLE, ETC.) ANY DURABLE, DISTINCT MONUMENT MAY BE USED. CORNERS SHALL BE REFERENCED WITH AT LEAST 4 DURABLE WITNESS MONUMENTS. WITNESS MONUMENTS SHALL BE MADE OF CONCRETE, NATURAL STONE, IRON OR OTHER EQUALLY DURABLE MATERIAL, EXCEPT WOOD. DESCRIBE THE CORNER AND THE WITNESS MONUMENTS.

2 2/(1)

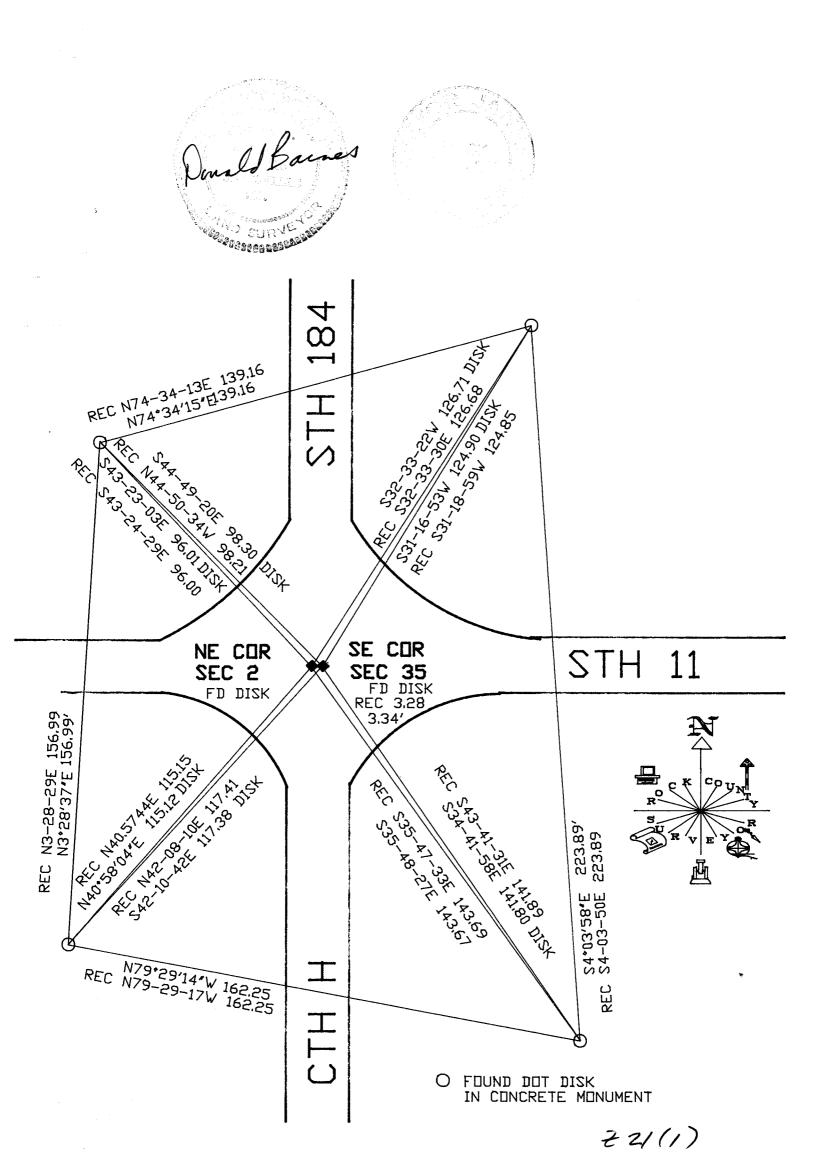

- (a) Describe any record evidence, monument evidence, occupational evidence, testimonial evidence or any other material evidence you considered, and whether the monument was found or placed.
- 1833 ORIG NOTES FOR T2N SHOWS THAT THE NE CORNER OF SECTION 2 IS WEST OF THE SE COR SEC 35 A DISTANCE OF 3.3'.
- 1868 LOCKE REMONUMENTATION INTERSECTED COR FOR TOWN 3. FOUND BT IN SEC 35 AND STUMP OF BT IN SEC 36 COR IN CENTER OF HIGHWAY. FIELD DISTANCE SHOWS THAT THE NE COR OF SEC 2 IS WEST OF THE SE COR SEC 35 A DISTANCE OF 3.3'
- 1877 RUGER VOL 2 PG 234 FOUND STONE MON AT THE NE COR SEC 2 BUT STATES NOTHING ABOUT SE COR SEC 35.
- 1933 SUNNY VOL 3 PG 235 SHOWS THE COR 3.3' WEST OF THE NE COR OF SEC 2. STATES NOTHING ABOUT THE SE COR OF SEC 35.
- 1933 SUNNY VOL 3 PG 234 AT THE NE COR OF SEC 2 SET 1" IRON PIPE 30" LONG IN CONCRETE PAVEMENT 2.4' NORTH OF CENTER OF SAME. DID NOT SET THE SE COR OF SEC 35. SHOWS A DISTANCE OF 2621.6 FROM THE NE COR OF SEC 2 TO THE W 1/4 COR SEC 2 & 2667.2' TO THE N 1/4 COR OF SEC 2.
- 1962 BATTERMAN JR. VOL 4 PG 142 FOUND 1" PIPE UNDER BLACKTOP WHICH IS THE NE COR SEC 2. ESTABLISHED REFERENCE TIES BUT DID NOT MONUMENT THE SE COR SEC 35.
- 1977 BARNES VOL 5 PG 362 FOUND NOTHING. PLACED ALUM MON AT REC DISTANCE. AT THE NE COR OF 2 FOUND 1" PIPE THAT DID NOT AGREE WITH RECORD TIES. SHOWS A DISTANCE OF 2656.86 BETWEEN THE N 1/4 & NE CORNERS OF SECTION 2.
- 1977 BARNES VOL 5 PG SHOWS A DISTANCE OF 2654.75 TO THE W 1/4 COR OF SEC 36 AND A DISTANCE OF 2639.52 FROM THE W 1/4 COR TO THE NW COR OF SEC 36
- 1979 SCHROEDER VOL 5 PG 531 SHOWS A DISTANCE OF 2659.50' TO THE S 1/4 COR OF SEC 35.

FOUND DOT DISK.

- (c) Was the corner restored through acceptance of (1) an obliterated evidence location, or, (2) a found perpetuated location?
 DID NOT ACCEPT DOT DISK. ACCEPTED TIES OF RECORD.
- (d) Describe any material discrepancy between the location of the corner as restored or reestablished and the location of that corner as previously restored or reestablished by distance and direction. Show the discrepancy on the plan view drawing under (a), above. Show the distances between the corner as previously restored or reestablished and (1) the corner as restored or reestablished, and (2) to at least 4 of the witness monuments shown on the drawing in (a), above.

 THE DISK IS 0.09' SOUTH AND 0.04' EAST OF THE CORRECT LOCATION.

I, Donald Barnes, hereby certify that the corner points as identified by the corner code index were, in a field survey on November 9, 1992, established, re-established, monumented, remonumented, recovered or restored as expressed below and in conformance with the regulations and rules as required in the current manual of survey instructions of the United States Department of Interior, Bureau of Land Management.