

PUBLIC LAND SURVEY MONUMENT RECORD

For Public Land Survey Corners in the


T. 1 N., R. 13 E.

CORNER CODE INDEX

	1	2	3	4	5	6	7	8	9	10	11	12	13	14	15	16	17	18	19	20	21	22	23	24	25
A																									
B																									
C																									
D																									
E																									
F																									
G																									
H																									
I																									
J																									
K																									
L																									
M																									
N																									
O																									
P																									
Q																									
R																									
S																									
T																									
U																									
V																									
W																									
X																									
Y																									
Z																									

PLACE MONUMENT SYMBOL (●) AT PROPER LOCATION ON ABOVE INDEX

EXAMPLE

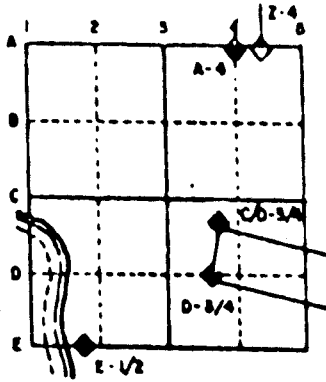

TURTLE TWP  
ROCK COUNTY WI

IF AVAILABLE  
STATE PLANE COORDINATES

North (Y) 213,942.93 Elev. (Z) \_\_\_\_\_

East (X) 517,294.72 Zone \_\_\_\_\_

Hor. Datum COUNTY Vert. Datum \_\_\_\_\_

◆ CORNER MONUMENT

○ WITNESS MONUMENT

*Fd C1*

*Fd TIES IN P17*

BEARINGS ARE BASED ON:

SHEET \_\_\_ OF \_\_\_

*P17 (1)*

CORNER CODE:

(B) Describe any record evidence, monument evidence, occupational evidence, testimonial evidence or any other material evidence you considered, and whether the monument was found or placed.

1972 LEE VOL 4 PG 585 SET CI. CALLS FOR 2651.27 TO NE COR SEC 22, 5305.12 TO W 1/4 COR SEC 22, 2651.27 TO SE COR SEC 22, AN ANGLE OF 88-36-18 FROM W 1/4 COR TO NE COR SEC 22, & AN ANGLE OF 91-23-42 FROM SE COR TO W 1/4 COR SEC 22.

1985 BARNES P17 FOUND CAST IRON MONUMENT & REFERENCED SAME.

FOUND CAST IRON MONUMENT & REFERENCE PIPE. DISTANCES AND ANGLES INDICATE THAT LEE DECLARED THE CORNER LOST AND ESTABLISHED BY SINGLE PROPORTIONATE MEASUREMENT. 2651.30 (REC 2651.27) TO NE COR SEC 22, 2650.87 (REC 2651.27) TO SE COR SEC 22, 5305.19 (REC 5305.12) TO W 1/4 COR SEC 22, ANGLE OF 91-23-44 (REC 91-23-42) FROM SE COR SEC 22 TO W 1/4 COR SEC 22, & ANGLE OF 88-36-04 (REC 88-36-18) FROM W 1/4 COR TO NE COR SEC 22.

C) Was the corner restored through acceptance of (1) an obliterated evidence location, or, (2) a found perpetuated location?  
ACCEPTED FOUND LOCATION.

D) Describe any material discrepancy between the location of the corner as restored or reestablished and the location of that corner as previously restored or reestablished by distance and direction. Show the discrepancy on the plan view drawing under (a), above. Show the distances between the corner as previously restored or reestablished and (1) the corner as restored or reestablished, and (2) to at least 4 of the witness monuments shown on the drawing in (a), above.

(E) Was the corner reestablished through lost corner proportionate methods? If so, show the method, including the directions and distances to other public land survey corners used as evidence or used for proportioning the corner location.  
NO

I, Donald Barnes, hereby certify that the corner points as identified by the corner code index were, in a field survey on, 1994, established, re-established, monumented, re-monumented, recovered or restored as expressed below and in conformance with the regulations and rules as required in the current manual of survey instructions of the United States Department of Interior, Bureau of Land Management.

COUNTY SURVEYOR FILING DATA

seal

Date of computer entry \_\_\_\_\_

Date microfilmed \_\_\_\_\_

Number of included sheets \_\_\_\_\_  
CORNER CODE \_\_\_\_\_

*Donald Barnes*  
7/14/95

EMBOSS LAND SURVEYOR SEAL

A-E 7.08 REQUIREMENT

P17(1)