

~~U.S. PUBLIC LAND SURVEY MONUMENT RECORD~~


For Public Land Survey Corners in the
T. 3 N., R. 11 E.

CORNER CODE INDEX

	1	2	3	4	5	6	7	8	9	10	11	12	13	14	15	16	17	18	19	20	21	22	23	24	25
A																									
B																									
C																									
D																									
E																									
F																									
G																									
H																									
I																									
J																									
K																									
L																									
M																									
N																									
O																									
P																									
Q																									
R																									
S																									
T																									
U																									
V																									
W																									
X																									
Y																									
Z																									

PLACE MONUMENT SYMBOL (◆) AT PROPER LOCATION ON ABOVE INDEX

EXAMPLE

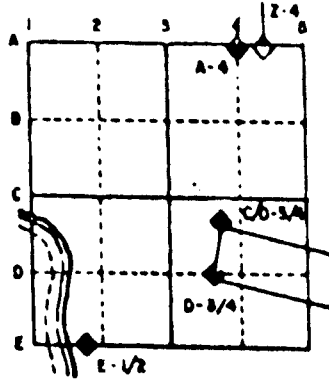

CENTER TWP
ROCK COUNTY WI

IF AVAILABLE
STATE PLANE COORDINATES

North (Y) _____ Eleve. (Z) _____
 East (X) _____ Zone _____
 Hor. Datum _____ Vert. Datum _____

◆ CORNER MONUMENT

○ WITNESS MONUMENT

BEARINGS ARE BASED ON:

ce626

(B) Describe any record evidence, monument evidence, occupational evidence, testimonial evidence or any other material evidence you considered, and whether the monument was found or placed.

1833 MULLETT & BRINK SET QUARTER SECTION POST IN PRAIRIE & MADE MOUND. CALLS FOR 2640 TO THE SE & SW CORNERS OF SEC 33.

1868 LOCKE REMONUMENTATION FIELD NOTES. FOUND OLD STAKE IN CENTER OF HIGHWAY & NEARLY IN LINE WITH FENCES RUNNING N/S. CALLS FOR THE CORNER TO BE 33.00' WEST OF THE N 1/4 COR SEC 4 THAT HE ESTABLISHED.

1934 SUNNY VOL 3 PG 236 CALLS FOR 33' OFFSET TO WEST. SHOWS N/S FENCE BUT STATES NOTHING ABOUT CORNER.

1988 BARNES Z11 FOUND 1" PIPE IN MONUMENT BOX. DID NOT ACCEPT CORNER. BECAUSE OF DISCREPANCY WITH LOCKE'S JOG DISTANCE.

FOUND BENT 3/4" REROD. REPLACED WITH 3/4X24 REROD. THE REROD IS ON LINE WITH THE NW CORNER OF SEC 4 AND THE 1" PIPE IN THE MONUMENT BOX. IT IS AT THE POSITION THAT LOCKE CALLS FOR WHEN HE ESTABLISHED THE N 1/4 COR SEC 4 PLYMOUTH TOWNSHIP. LOCKE'S JOG DISTANCE IS 33.00'.

C) Was the corner restored through acceptance of (1) an obliterated evidence location, or, (2) a found perpetuated location?

ACCEPTED EVIDENCE LOCATION AS PERPETUATED BY LOCKE'S POSITION OF THE N 1/4 COR SEC 4 AND HIS JOG DISTANCE.

D) Describe any material discrepancy between the location of the corner as restored or reestablished and the location of that corner as previously restored or reestablished by distance and direction. Show the discrepancy on the plan view drawing under (a), above. Show the distances between the corner as previously restored or reestablished and (1) the corner as restored or reestablished, and (2) to at least 4 of the witness monuments shown on the drawing in (a), above.

DID NOT ACCEPT THE FOUND 1" PIPE IN THE MONUMENT BOX.

(E) Was the corner reestablished through lost corner proportionate methods? If so, show the method, including the directions and distances to other public land survey corners used as evidence or used for proportioning the corner location.

NO

I, Donald Barnes, hereby certify that the corner points as identified by the corner code index were, in a field survey on, April 27, 1995, established, re-established, monumented, re-monumented, recovered or restored as expressed below and in conformance with the regulations and rules as required in the current manual of survey instructions of the United States Department of Interior, Bureau of Land Management.

COUNTY SURVEYOR FILING DATA

Date of computer entry _____

Date microfilmed _____

Number of included sheets 2
CORNER CODE

seal
Donald Barnes

April 28, 1995

EMBOSS LAND SURVEYOR SEAL

211 (1)

