
U.S.

SURVEY "UBLIC MONUMENT RECORD

For Public Land Survey Corners in the T. _ M., R. 13 E

CORNER CODE INDEX

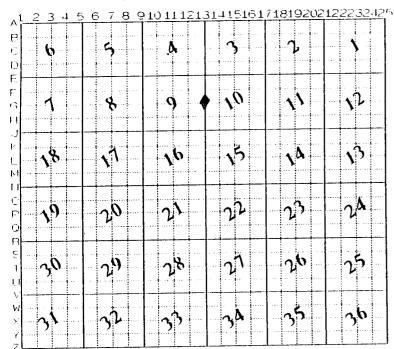

TURT	LE	TWI
ROCK	COUNTY	W1

	IF AVAILABLE	
ROCK	COUNTY COORDINATES PER	FEBBEL

North 224,715,4/ Elev.

East 5/2, 034,59

Hor. Datum COUNTY Vert. Datum _____

GPS	(%)	# MATE TAXABLE 1.00	TRAVERSE	(x)	

BASED ON THE FOLLOWING CONTROL:

PLACE MONUMENT SYMBOL & LOCATION ON ABOVE INDEX

OCORNER MONUMENT

O WITHESS MONUMENT

(a)

BEARINGS ARE BASHD

Fd FIBERGLASS MON.

FD TIES IN G13

FIELD BOOK PAGE #

SHOW A PLAN VIEW DRAWING DEPICTING THE COTHER MONUMENT AND SUPPOUNDING PAGE

THE FOLLOWING CHARACTERISTICS: 1) HAVE A LEAST TWO PREDETERMINED BREAK-OFF R

THIST PRESIDENCE. 40 THE CAP IS DISCRIPTED TROCK COURTS SURVEY HOWEVER

OF BRIDE HAV DEFUSED THE ARMAS MEDIES CROWN WHEN IS WITHIN ONE FOOL OF THE

ORDABIC, OTSTITICT POWERENT HAS DE USED. CONHERS SHALL BE DEFERENCED WITH AT

STONE, IRON OR OTHER EQUÂLLY DUBBLE MATERIAL E-CEPT MOOD. DESCRIPE THE COMM FEATURES, INCLUDING THE EXCAVATION AREA AND DEPTH. THE CORNER MONAMENT SHALL HAVE, 5. 2) IF BROKETL LEAVE A PERTAMENTLY MAGNETIZED REMAINT AT THE ORIGINAL POINT, NALLY FOR DISTURBING MARKER? 5) OR AN EXISTING CUT LIVESTORE. AN IRVAN PIFE I 1/2"Y INCL. IF THE CONNER IS COCURED BY AN EXPROMENTED BY BROKET BRANCH PROBLEBURIED CARLECTO AND I 4 DURABLE WITHERS INGUINED BY MILLERS MONAMENTS SHALL BE HADE OF COMPANYED THAT OR INCLUDING.

PLAINING & ZONINO COMMITTEE ADOPTED THE ABOVE FORM ON 12/2/1982 WT ADMITISTRATIVE CODE A-E 7.08 REQUIRENELL

SHEET ___OF ___

- (B) Describe any record evidence, monument evidence, occupational evidence, testimonial evidence or any other material evidence you considered, and whether the monument was found or placed.
- 1864 LOCKE VOL 1 PG 204 FOUND S. BT CALLS FOR 2655.84 TO CENTER SEC 10 & 5311.68 TO E 1/4 COR SEC 10.
- 1865 LOCKE VOL 1 PG 229 FOUND S. BT & OLD STAKE. SET STAKE & SURROUNDED WITH 3 HH. CALLS FOR 2655.84 TO NW COR SEC 10 & 2655.84 TO CENTER OF SEC 10.
- 1868 LEE VOL 1 PG 334 FOUND SW BT & OLD STAKE. SET NEW BR. OAK STAKE.
 1882 HOLMES FOUND STAKE & STONES & WHERE STUMP OF SW BT HAD BEEN DUG
 UP. CALLS FOR 1324.29 TO S 1/16TH OF NE 1/4 SEC 9 COR (LS) & 2659.14 VAR 5-56 TO NE COR SEC 9.
- 1882 LEE VOL 2 PG 368 BR OAK STAKE SURROUNDED BY 3 HH. CALLS FOR 2647.10 TO CENTER OF SEC 9.
- 1919 BATTERMAN VOL 3 PG 80 FOUND OLD STAKE SURROUNDED BY 3HH. IRON ROD SURROUNDED BY HHs. CALLS FOR 2648.1 TO CENTER OF SEC 9.
- 1952 SHIMEAL VOL 6 PG 364 CALLS FOR 2667.60 TO SE COR SEC 9 & AN ANGLE OF 91-08-20 FROM THE SE COR TO CENTER COR OF SEC 9.
- 1964 BATTERMAN VOL 4 PG 204 FOUND PIN & REFERENCED SAME. 1986 BARNES VOL 6 PG 364 FOUND ROD. CALLS FOR 2655.83 TO CENTER SEC 9,2665.98 TO SE COR SEC 9,& AN ANGLE OF 91-07-39 FROM THE SE COR TO CENTER COR OF SEC 9.
- 1986 BARNES G13 FOUND 3/4X24 PIN SURROUNDED BY SMALL HH. 24" DEEP FOUND PIN SURROUNDED BY 3 LARGE HH. DROVE PIN DEEP & REMOVED HHS. PLACED FIBERGLASS MON ON TOP OF PIN. MON IS 2' SOUTH OF THE E/W CENTER OF RD TO THE EAST & 1' SOUTH OF THE E/W CENTER OF THE ROAD REFERENCED SAME. TO THE WEST.

FOUND FIBERGLASS MONUMENT & TIES. S0-04-12W 2665.98.

- Was the corner restored through acceptance of (1) an obliterated evidence location, or, (2) a found perpetuated location? ACCEPTED FOUND MONUMENT.
- Describe any material discrepancy between the location of the corner as restored or reestablished and the location of that corner as previously restored or reestablished by distance and direction. Show the discrepancy on the plan view drawing under (a), above. Show the distances between the corner as previously restored or reestablished and (1) the corner as restored or reestablished, and (2) to at least 4 of the witness monuments shown on the drawing in (a), above.
- Was the corner reestablished through lost corner proportionate methods? If so, show the method, including the directions and distances to other public land survey corners used as evidence or used for proportioning the corner location. NO
- I, Donald Barnes, hereby certify that the corner points as identified by the corner code index were, in a field survey on, 1994, established, re-established, monumented, re-monumented, recovered or restored as expressed below and in conformance with the regulations and rules as required in the current manual of survey instructions of the United States Department of Interior, Bureau of Land Management.

COUNTY SURVEYOR FILING DATA	
Date of computer entry	
Date microfilmed	
Number of included sheets	
CORNER CODE	_

Seal Baines
U1/95 EMBOSS LAND SURVEYOR SEAL

A-E 7.08 REQUIREMENT