

PUBLIC LAND SURVEY MONUMENT RECORD

For Public Land Survey Corners in the


T. 1 N., R. 13 E

CORNER CODE INDEX

	1	2	3	4	5	6
A						
B						
C						
D						
E						
F						
G						
H						
I						
J						
K						
L						
M						
N						
O						
P						
Q						
R						
S						
T						
U						
V						
W						
X						
Y						
Z						

PLACE MONUMENT SYMBOL (◈) AT PROPER LOCATION ON ABOVE INDEX

EXAMPLE

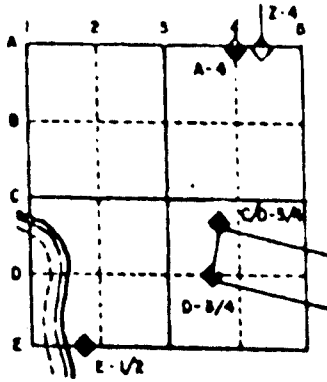

TURTLE TWP
ROCK COUNTY WI

IF AVAILABLE
STATE PLANE COORDINATES

North (Y) 228,049.43 Elev. (Z) _____
East (X) 512,031.34 Zone _____
Hor. Datum COUNTY Vert. Datum _____

◈ CORNER MONUMENT

○ WITNESS MONUMENT

Fd Poly mon &
CARSONITE POST ON
NW SIDE.

Fd TIES IN J13

BEARINGS ARE BASED ON:

SHEET ___ OF ___

J13(1)

CORNER CODE:

(B) Describe any record evidence, monument evidence, occupational evidence, testimonial evidence or any other material evidence you considered, and whether the monument was found or placed.

- 1867 LEE VOL 1 PG 333 FOUND FENCE POST TESTIFIED TO BE CORNER. 2651.88 TO N 1/4 COR SEC 15.
1880 LEE VOL 2 PG 304 FOUND OLD FENCE AT CORNER. 2647.92 TO N 1/4 COR SEC 15.
1882 HOLMES VOL 2 PG 356 ANGLE AT SOD FENCE.
1952 SHIMEALL PLACED PIPE IN PLACE OF OLD POST USED BY LOCKE IN 1860.
1986 BARNES VOL 6 PG 364 FOUND PIPE 2666.65 TO S 1/4 COR SEC 9, 2654.97 TO S 1/4 COR SEC 10, 2659.73 TO E 1/4 COR SEC 16, 2665.98 TO E 1/4 COR SEC 9, AN ANGLE OF 88-40-17 (SHIMEALL 88-41-40) FROM S 1/4 COR SEC 9 TO E 1/4 COR SEC 9.
1986 J13 FOUND AND REPLACED A 1 1/4X4' PIPE WITH A POLY MONUMENT. PLACED A CARSONITE POST ON THE NW SIDE OF THE MONUMENT. REFERENCED CORNER.

FOUND POLY MON. & REFERENCE PIPES.

C) Was the corner restored through acceptance of (1) an obliterated evidence location, or, (2) a found perpetuated location?
ACCEPTED FOUND PERPETUATED LOCATION.

D) Describe any material discrepancy between the location of the corner as restored or reestablished and the location of that corner as previously restored or reestablished by distance and direction. Show the discrepancy on the plan view drawing under (a), above. Show the distances between the corner as previously restored or reestablished and (1) the corner as restored or reestablished, and (2) to at least 4 of the witness monuments shown on the drawing in (a), above.

(E) Was the corner reestablished through lost corner proportionate methods? If so, show the method, including the directions and distances to other public land survey corners used as evidence or used for proportioning the corner location.

NO

I, Donald Barnes, hereby certify that the corner points as identified by the corner code index were, in a field survey on, 1994, established, re-established, monumented, re-monumented, recovered or restored as expressed below and in conformance with the regulations and rules as required in the current manual of survey instructions of the United States Department of Interior, Bureau of Land Management.

seal

Donald Barnes

7/13/95

EMBOSS LAND SURVEYOR SEAL

COUNTY SURVEYOR FILING DATA

Date of computer entry _____

Date microfilmed _____

Number of included sheets _____
CORNER CODE

A-E 7.08 REQUIREMENT

J13 (1)