

Paper weight-110# (minimum)

Black nonfading ink required

# U.S. PUBLIC LAND SURVEY MONUMENT RECORD

For Public Land Survey Corners In:

WI ADMINISTRATIVE CODE A-E 7.08 REQUIREMENT

T. 1 N. R. 12 E. 4th P.M.

REV 10/23/2004

USMONREC.DWG

CORNER CODE INDEX

Beloit TWP

ROCK COUNTY WI

IF AVAILABLE

ROCK COUNTY COORDINATES PREFERRED

A	1	2	3	4	5	6	7	8	9	10	11	12	13	14	15	16	17	18	19	20	21	22	23	24	25	A	
B																										B	
C	6						5					4					3						2			1	C
D																											D
E																											E
F	7						8					9					10						11			12	F
G																											G
H																											H
J																											J
K	18						17					16					15						14			13	K
L																											L
M																											M
N																											N
O																											O
P	19						20					21					22						23			24	P
Q																											Q
R																											R
S																											S
T																											T
U	30						29					28					27						26			25	U
V																											V
W																											W
X	31						32					33					34						35			36	X
Y																											Y
Z																											Z

North \_\_\_\_\_ Elev. \_\_\_\_\_

East \_\_\_\_\_

Hor. Datum \_\_\_\_\_ Vert. Datum \_\_\_\_\_

LATITUDE \_\_\_\_\_ ELLIPS. HT. \_\_\_\_\_

LONGITUDE \_\_\_\_\_

NAD83(91) \_\_\_\_\_ NETWORK ADJ. YR 2010

GPS (X) \_\_\_\_\_ TRAVERSE (X) X

BASED ON THE FOLLOWING CONTROL:

PLACE MONUMENT SYMBOL  AT PROPER LOCATION ON ABOVE INDEX

CORNER MONUMENT

WITNESS MONUMENT

(a) BEARINGS ARE BASED ON: ROCK COUNTY PROJECTION

FIELD BOOK \_\_\_\_\_ PAGE # \_\_\_\_\_

OR OBSERVATION SHEET \_\_\_\_\_

SHEET 1 OF 4

SHOW A PLAN VIEW DRAWING DEPICTING THE CORNER MONUMENT AND SURROUNDING PHYSICAL FEATURES, INCLUDING THE EXCAVATION AREA AND DEPTH.

PLANNING & ZONING COMMITTEE ADOPTED THIS FORM ON 12/2/1982

CORNER CODE V-5(2)

BE603 NE COR SEC 31

(B) ~~\_\_\_\_\_~~ record evidence, monument evidence, ~~\_\_\_\_\_~~ operational evidence, testimonial evidence, ~~\_\_\_\_\_~~ other material evidence you considered, and whether the monument was found or placed.

- 1834 HARRISON NORTH BETWEEN SECS 31 & 32
- 1145.76 BURR OAK 12 IN DIAM
- 2640 QUARTER SEC. COR. BURR OAK N60W 61.38, BURR OAK 12S34W 19.14
- 3102 BURR OAK 12 IN DIAM
- 4676.76 BURR OAK 12 IN DIAM
- 5049 RANDOM STATE LINE
- 5280 COR TO SEC 29,30,31,32 BURR OAK 12 N31W 81.18' NORTH BETWEEN SECS 29 & 30
- 1261.92 BROOK 5.28' CRS S.W.
- 2640 QUARTER SEC COR. BURR OAK 12 N31W 81.18', BURR OAK 12 S68W 29.7'
- 3774.54 BURR OAK 8 & ENTER SCATY TIMBER
- 5280 COR. TO SECS 19-20-29-30 TIMBER ADJACENT TOO SMALL WHEREON ESTABLISH COR I THEREFORE SET POST & RAISED MOUND EAST ON RAND. BET 29 & 32
- 528 LEAVE TIMBER & ENTER MARSH
- 2640 TEMPY 1/4 POST
- 2970 LEFT MARSH & ENTER TIMBER
- 4620 LEFT TIMBER & ENTER PRAIRIE
- 5273.4 INT. EAST BOUNDARY 10.56' N OF POST. LAND LEVEL & MOSTLY WET 2ND RATE COR WEST
- 2294.82 BURR OAK 12
- 2636.7 QUARTER SEC COR. BUR OAK 10 S71E 231', BURR OAK 14 N35E 251.46'
- 5273.4 SEC COR WEST BET SECS 30 & 31 ON RAND.
- 495 BROOK 6.6' CRS S.W.
- 2640 TEMPY 1/4 SEC COR.
- 2838 BROOK 9.24' CRS S.E.
- 5217.3 INT. WEST BOUNDARY 10.56' SOUTH OF POST & ESTABLISH COR TO SECS 30 & 31. BURR OAK 30 N15E 104.94', BURR OAK 18 S29E 19.14' COR EAST BET 30 & 31
- 2577.33 QUARTER SEC COR BURR OAK 14 N47W 25.08' RED OAK 18 S76E 104.28'
- 5217.3 SEC COR.

1846 TOWN ROAD RECORDS BK 1 PG 58 CORNER AT CENTER OF ROAD  
1859 TOWN ROAD RECORDS BK 2 PG 76,78,79 ROAD DESCRIPTION BEGAN AT CORNER.

1931 SUNNY VOL 3 PG 189 DUG 4X2 HOLE 3' DEEP & FOUND NOTHING TO INDICATE SEC. CORNER.

1952 DOT STH 81 2649.00 TO N 1/4 COR SEC 32

1959 BATTERMAN VOL 4 PG 6 2641.33 TO N 1/4 COR SEC 31, 2649.10 TO E 1/4 COR SEC 31 & REFERENCED SAME. WPL N/S 187,645.60; E/W 2,239,897.58.

1969 BATTERMAN VOL 4 PG 384 SCRIBED CROSS IN CONCRETE & REFERENCED SAME. CALLS FOR COR @ CENTER OF LIBERTY AVE. & PADDOCK ROADS.

1975 SPRAGUE MAP #6039 N/S 187,645.60; E/W 2,239,897.88.

1975 SPRAGUE MAP #6044 N/S 187,643.2; E/W 2,239,899.12. 2641.51 TO N 1/4 COR SEC 31

1976 BARNES VOL 5 PG 128 FD CUT "X" WITH PK & REFERENCED SAME.

1979 BARNES VOL 6 PG 3. USED TIES ON RECORD. SET ALUM. MON. SEAL

SHEET 1 OF 4

EMBOSSSED

CORNER CODE V-5(2)

*Dwight Barnes*

*March 28, 2011*

BE603 NE COR SEC 31

1983 LEE MAP #14004 2641.53 TO N 1/4 COR SEC 31, 2650.95 TO E 1/4 COR SEC 30, & ANGLE 88-10-00 FROM S 1/4 COR SEC 30 TO E 1/4 COR SEC 30. FOUND PIN.

1993 LEUNBERGER MAP #9798 CALLS FOR A DISTANCE TO THE SURVEY.

1998 BARNES V-5 FD ALUM MON. & REFERENCED SAME

1998 BARNES BELOIT TOWN PROJECT.

SO-2-04E 2649.02 TO E 1/4 COR SEC 31

1959 BATTERMAN 2649.10

S88-48-00E 2648.68 TO N 1/4 COR SEC 32

N88-45-01W 2641.38 TO N 1/4 COR SEC 31

1959 BATTERMAN 2641.33

1983 LEE 2641.53

1975 SPRAGUE 2641.51

NO-35-08W 2650.90 TO E 1/4 COR SEC 30

1983 LEE 2650.95

ANGLE 88-09-53 [LEE 88-10-00] @ SE COR SEC 30 FROM S 1/4 COR SEC 30 TO E 1/4 COR SEC 30. ANGLE 91-17-03 [SPRAGUE 91-18-32] @ SE COR SEC 30 FROM E 1/4 COR SEC 31 TO N 1/4 COR SEC 31.

PRIOR TO GRINDING I FD NOTHING AT PVMT SURFACE. AFTER GRINDING I FD ALUM MON 2.0' SOUTH OF OLD PVMT CENTER LINE PAINT MARKING. MON CAP & STUD WERE GROUND OFF TO TOP FLAT PORTION OF MON. THE TIES INDICATE THE ALUM MAY HAVE BEEN HIT & MOVED. IT IS 2' SOUTH OF OLD PAINTED CENTER LINE & AT GRIND LEVEL.

IN OCTOBER 2010 AFTER PAVING, THE PROJECT ENGINEER REQUESTED I MARK THE LOCATION FOR MONUMENT INSTALLATION. I MARKED IT BY PLACING 4 MAG NAILS SO A STRING COULD BE PULLED BETWEEN TWO OPPOSITE NAILS AND THE INTERSECTION WOULD BE THE SPOT. I PAINTED THE INTERSECTION LOCATION AND THE 4 MAG NAILS. ON MARCH 21, 2011 I WENT TO THE SITE TO CHECK THE LOCATION WITH THE TIES. THERE WAS NO MONUMENT AT THE SURFACE NOR THE MAG NAILS. THERE PROBABLY WAS A SECOND LAYER PLACED ON TOP OF THE NAILS.

C) Was the corner restored through acceptance of (1) an obliterated evidence location, or, (2) a found perpetuated location?

ACCEPTED FD ALUM. MON.

D) Describe any material discrepancy between the location of the corner as restored or reestablished and the location of that corner as previously restored or reestablished by distance and direction. Show the discrepancy on the plan view drawing under (a), above. Show the distances between the corner as previously restored or reestablished and (1) the corner as restored or reestablished, and (2) to at least 4 of the witness monuments shown on the drawing in (a), above.

SEAL  
Donald Barnes  
EMBOSSED

SHEET 2 OF 4  
CORNER CODE V-5(2)

March 28, 2011

BE603 NE COR SEC 31

(E) Was the corner reestablished through lost corner proportionate methods? If so, show the method, including the directions and distances to other public land survey corners used as evidence or used for proportioning the corner location.

NO

I, **DONALD BARNES**, hereby certify that the corner location as identified by the corner code index was determined by me under my direction and control and that this U.S. Public Land Survey Monument Record is correct and complete to the best of my knowledge and belief.

Seal

*Donald*

Emboss

*Barnes*

*March 28, 2011*

SHEET 3 OF 4

CORNER CODE


**V-5(2)**

A.E. 7.08 REQUIREMENT



1969 VOL 4 PG 384  
 1976 VOL 5 PG 128  
 1998 OBSERVATION SHEET #191  
 2010 OBSERVATION SHEET #191  
 & #270 ELEV. ARE BASED ON  
 DIGITAL AIR PHOTOS

**NE COR  
 SEC 31  
 BELOIT TWP  
 T1N R12E**

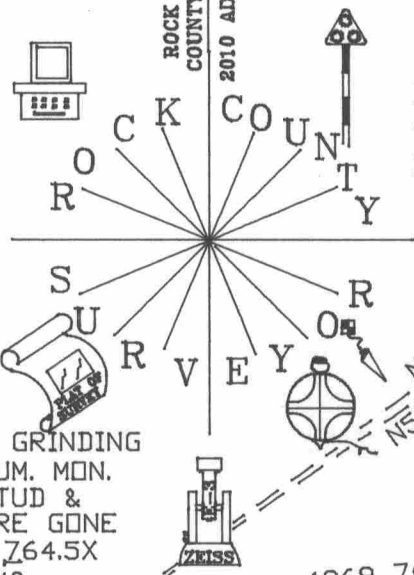

AFTER GRINDING  
 FD ALUM. MON.  
 TOP STUD &  
 CAP ARE GONE  
 ELEV 764.5X

1976 FD BENT IP  
 & REPLACED  
 WITH G-1  
 FD G-1 MON  
 ELEV 762.9X

1969 76.60  
 N84-18E 76.6X

CELL N52-01-55E 7,520'  
 N54-54-05E 12,781'  
 SEARCHED & FD NOTHING  
 1969 PIPE

X8'E2 M60-IN  
 FD 3/4X24 REROD  
 ELEV 762.7X

**PADDOCK RD.**

36' TREE

SEARCHED  
 & FD NOTHING  
 1969 REC PIPE

WATER TANK  
 N54-28-50E  
 12,796'

ELEV 762.2X  
 FD 1" PIPE

S4-59-16W 137.79  
 1976 138'  
 1969 137.85

S7-39E 82.0X  
 1969 82.00

**STH 81**

N21-24-58E  
 1998 48.44  
 1969 48.40

N26-35-04E  
 1976 54.47  
 1969 54.47

S2-41E 96.6X  
 1969 96.61

N1-15W 143.3X  
 1969 143.30

EMBOSSED  
 SEAL

1969 REC PIPE

N45-45E 75.00  
 1969 74.96

N46-08-38E 66.13  
 1969 66.13

S73-25E 66.13  
 1969 66.13

S33-53-54E 62.60  
 1976 62.60

S8-36-06E 95.60  
 1969 95.61

S2-41E 96.6X  
 1969 96.61

N1-15W 143.3X  
 1969 143.30

**BRICK HSE**

1969 91.68  
 1976 91.68  
 N88-59E 91.3X  
 SHEET 4 OF 4

COMPUTED

S80-38E 5.3X  
 XXXXXXXX

ELEV 762.7X  
 FD PIPE

1969 PIPE  
 1976 FD PIPE  
 SEARCHED  
 & FD NOTHING

**V-5(1)**

EMBOSSED  
 SEAL  
*Dwight Baring*  
 March 28, 2011