
$\mathbf{U}.\mathbf{S}.$

SURVEY TUBLIC MONUMENT RECORD

For Public Land Survey Corners in the T. 1 N., R. 13 E

CORNER CODE INDEX

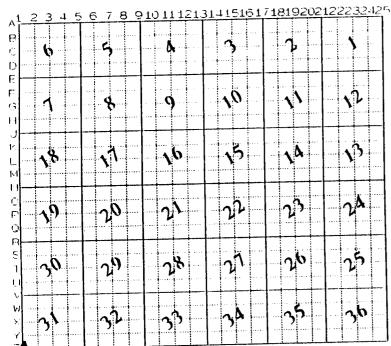

TURTLE ROCK COUNTY WI

1F AVAILABLE ROCK COUNTY COORDINATES PERFERRED

North 201,01943 Elev.

East 496,192,33

Hor. Datum COUNTY Vert. Datum

GPS (X) ____

TRAVERSE (X)

BASED OF THE FOLLOWING CONTROL:

PLACE MONUMENT SYMBOL & LOCATION ON ABOVE INDEX

OCORNER MONUMENT

O WITHESS MONUMENT

(a)

BEARINGS ARE BASED ON:

FOR MONBOX WITH H#

Fd TIES IN Z/

GO PHYSICAL FEATURES, INCLIDING THE EXCAVATION AREA AND DEPTH. THE CORNER MOMERENT SHALL HAVE, GOTHERS, 21 IF BROKET LEAVE A REPRIATEDLY MAGNETIZED REMAINT AT THE ORIGINAL POINT, FROM 1 PENALTY FOR DISTURBING MARKETT 5) OR AN EXISTING CUT LIBERIOTE. AT INVESTIGATION OF THE SUBJECT. IN THE CORNER IS OCCUPIED BY AN INFORMER MITHER FLATERIFIED CARLESTED AND RESISTING CORNER AND THE MALE OF CONTROL MATERIAL MITHERS MOMERTHIS SHALL BE HAVE OF CONTROL MATERIAL CONTROL OF MALE AND THE MALE OF CONTROL MATERIAL FIELD BOOK

PAGE #

SHOW A PLAN VIEW DRAINTING DEPICTING THE CONTERN MONUMENT AND SUPPOLICING PH

10 FORLOWING CHARACTERISTICS: 1) HAVE A LEAST TWO PREDETERMINED BREAK-OFF

21 HISTOPIE EXISTINCT HAVE AS THE CAP IS THISCHIEDED THOOK CONTEXN SURVEY HAVE AS

11 HISTOPIE HAVE BE USED THAT HAVE ME HE ORCHOW WHEN IS WITHIN ONE, FOOL OF

12 ONTABLE, DISTINCT EXISTENT HAVE BE USED. CONTERNS SHALL BE REFERENCED WITH

STONE, FROM CONTEXN BE USED. CONTERNS SHALL BE REFERENCED WITH

STONE, FROM CONTEXN BE USED. CONTERNS SHALL BE REFERENCED WITH

STONE, FROM CONTEXN BE USED. CONTEXN BE USED

ELAINING & ZONING COMMITTEE ADOPTED THE ABOVE FORM ON 12/2/1982 WI ADMINISTRATIVE CODE A-E 7.08 REQUIREMENT

SHEET ___OF

- (B) Describe any record evidence, monument evidence, occupational evidence, testimonial evidence or any other material evidence you considered, and whether the monument was found or placed.
- 1835 BRINK SET QUARTER SECTION POST BUR OAK 7 S65W .53 7 BUR OAK 8 N47W 114. CALLS FOR 2640 TO SW COR SEC 31 & ARMY TRAIL @NNW 2046 NORTH OF CORNER.
- 1874 RUGER VOL 2 PG 149 VAR 4-25 2641.98 TO S 1/4 COR SEC 31 & VAR 4-30 2636.04 TO W 1/4 COR SEC 31.
- 1980 BARNES Z-1 FOUND HH IN ROUND CAST IRON MON. BOX. MON MAY BE DESTROYED BY INSTALLATION OF WATER MAIN. CORNER IS SOUTH OF PAVEMENT. REFERENCED SAME.

FOUND HH IN CAST IRON MON BOX & REFERENCE TIES FROM Z-1

- C) Was the corner restored through acceptance of (1) an obliterated evidence location, or, (2) a found perpetuated location?
 ACCEPTED FOUND PERPETUATED LOCATION.
- D) Describe any material discrepancy between the location of the corner as restored or reestablished and the location of that corner as previously restored or reestablished by distance and direction. Show the discrepancy on the plan view drawing under (a), above. Show the distances between the corner as previously restored or reestablished and (1) the corner as restored or reestablished, and (2) to at least 4 of the witness monuments shown on the drawing in (a), above.
- (E) Was the corner reestablished through lost corner proportionate methods? If so, show the method, including the directions and distances to other public land survey corners used as evidence or used for proportioning the corner location.

I, Donald Barnes, hereby certify that the corner points as identified by the corner code index were, in a field survey on,1994, established, re-established, monumented, re-monumented, recovered or restored as expressed below and in conformance with the regulations and rules as required in the current manual of survey instructions of the United States Department of Interior, Bureau of Land Management.

COUNTY SURVEYOR FILING DATA

Date of computer entry____

Date microfilmed _____

Number of included sheets _ CORNER CODE

A-E 7.08 REQUIREMENT

EMBOŚS LAND SURVEYOR SEAT