

PUBLIC LAND SURVEY MONUMENT RECORD


For Public Land Survey Corners in the
T. 1 N., R. 13 E.

CORNER CODE INDEX

	1	2	3	4	5	6	7	8	9	10	11	12	13	14	15	16	17	18	19	20	21	22	23	24	25
A																									
B																									
C	6																								
D					5																				
E																									
F																									
G																									
H	7																								
J																									
K																									
L																									
M	8																								
N																									
O																									
P																									
Q	9																								
R																									
S																									
T																									
U	30																								
V																									
W																									
X																									
Y																									
Z																									

PLACE MONUMENT SYMBOL (◆) AT PROPER LOCATION ON ABOVE INDEX

EXAMPLE

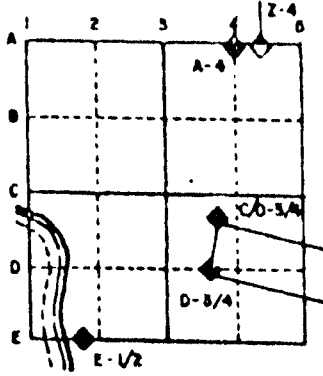

TURTLE TWP
ROCK COUNTY WI

IF AVAILABLE
STATE PLANE COORDINATES

North (Y) _____ Eleve. (Z) _____
 East (X) _____ Zone _____
 Hor. Datum _____ Vert. Datum _____

◆ CORNER MONUMENT

○ WITNESS MONUMENT


BEARINGS ARE BASED ON:

SHEET _____ OF _____

CORNER CODE: N/A

PRAIRIE AVE.

CONCRETE

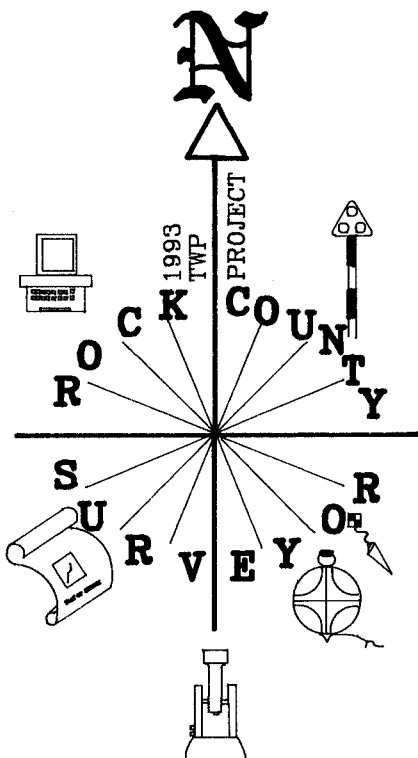

OBSERVATION SHEETS

DID NOT FIND ANYTHING


MURPHY WOODS RD

NW COR
SEC 19

FD 1" IF
BY R/W
POST

Donald Barnes
7/14/95


N(1)

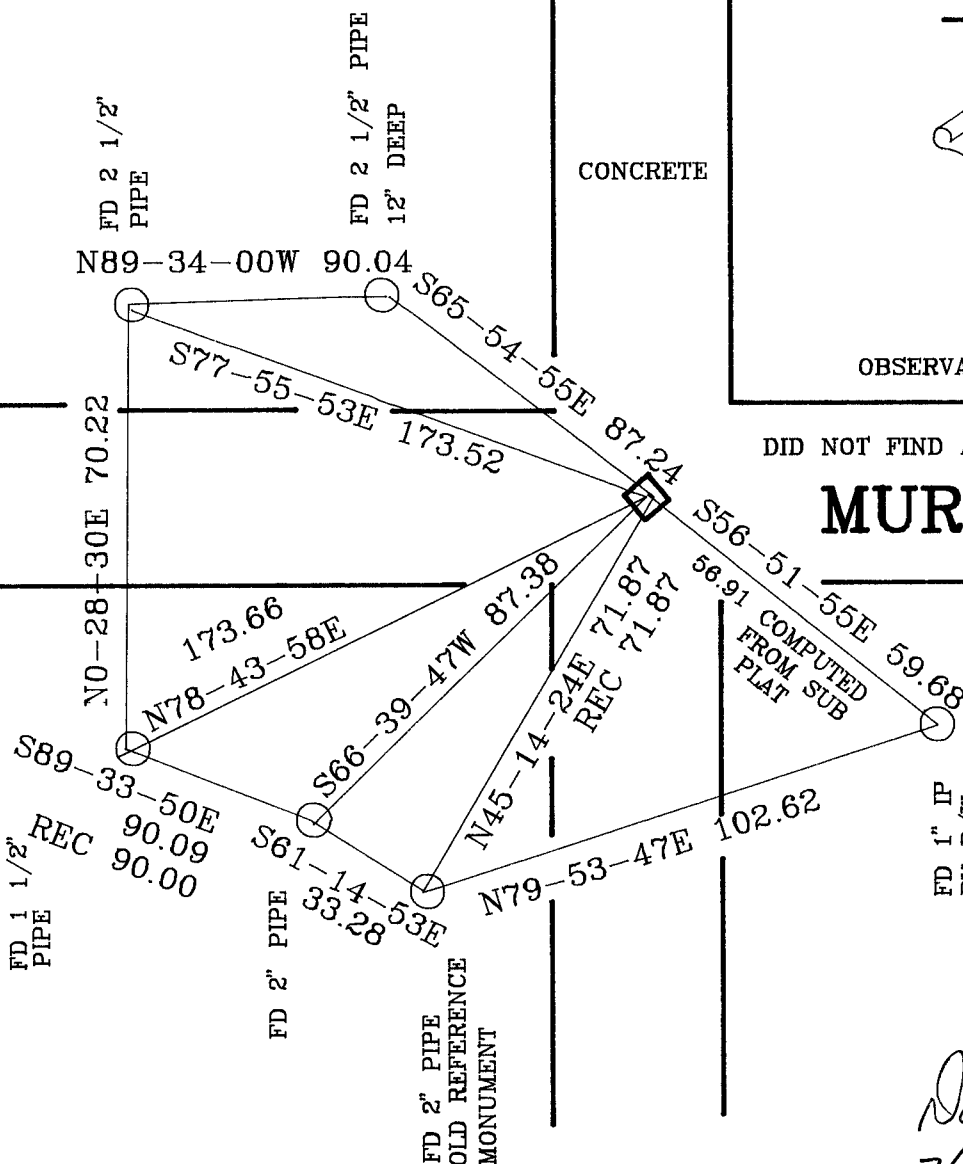

PRAIRIE AVE.

MURPHY WOODS RD

COMPUTED FROM SUBDIVISION

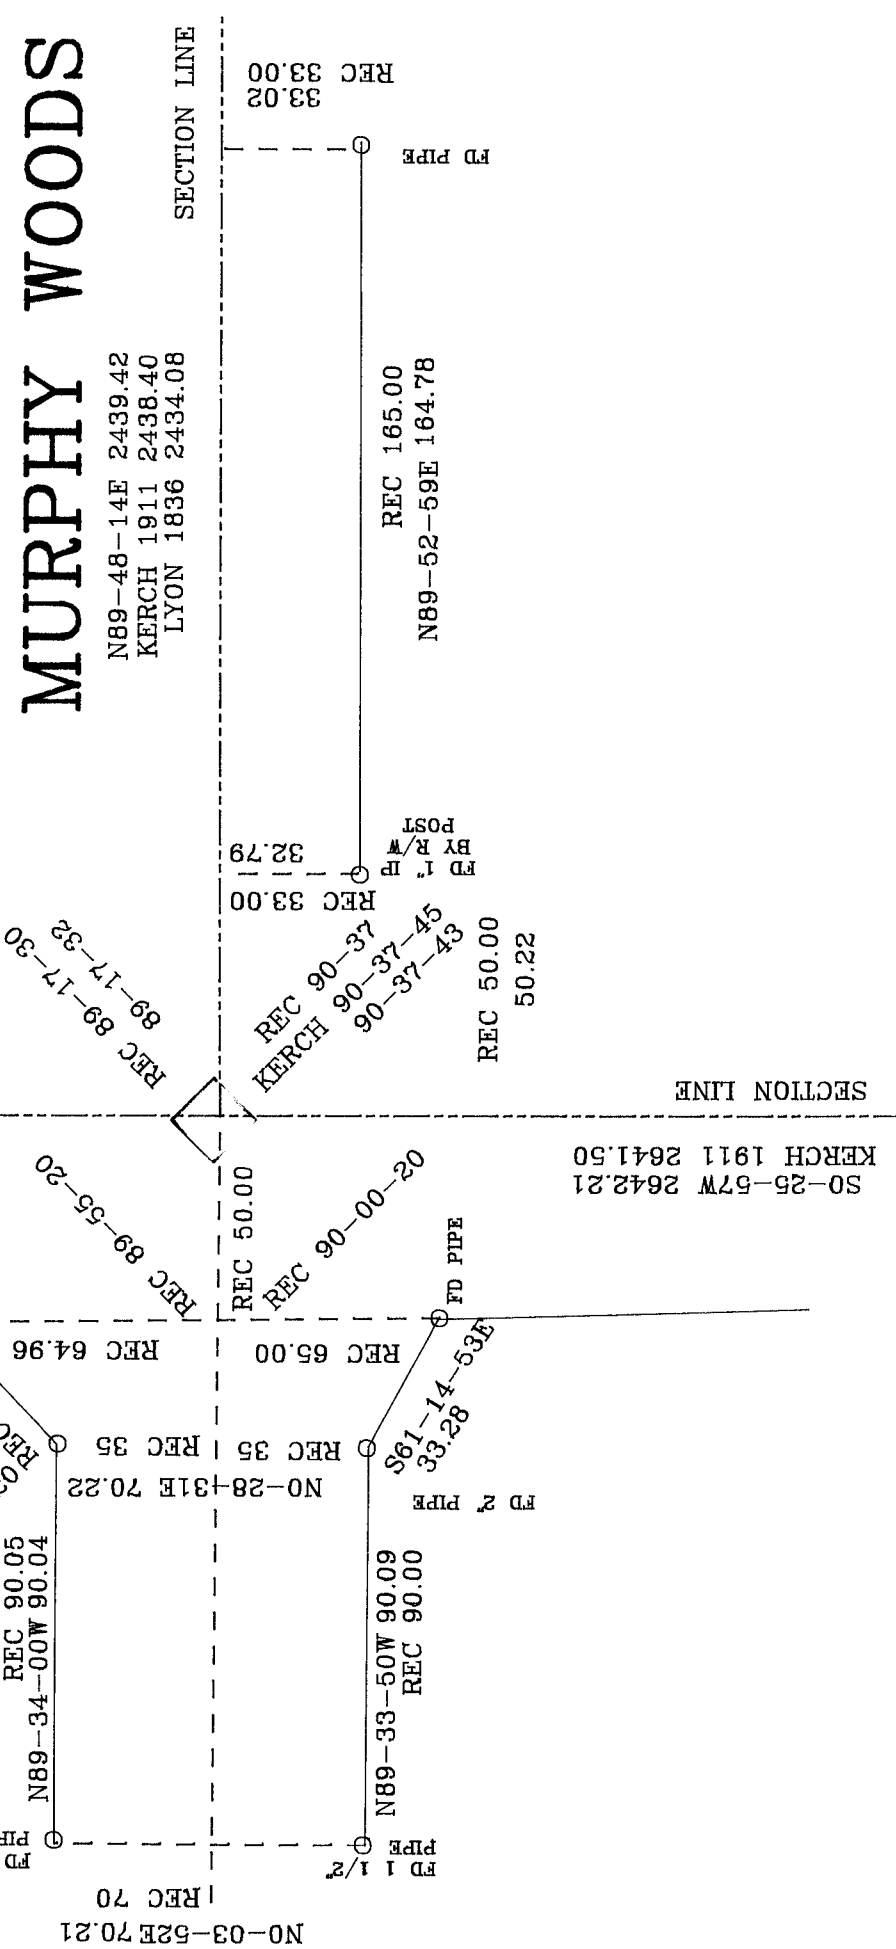

Donald Barnes
7/1/95

2112