

PUBLIC LAND SURVEY MONUMENT RECORD

For Public Land Survey Corners in the


T. 1 N., R. 13 E.

CORNER CODE INDEX

	1	2	3	4	5	6	7	8	9	10	11	12	13	14	15	16	17	18	19	20	21	22	23	24	25
A																									
M																									
L	6																								
D		5																							
E			4																						
F				3																					
G					2																				
H																									
I																									
J																									
K																									
L																									
M																									
N																									
O																									
P																									
Q																									
R																									
S																									
T																									
U																									
V																									
W																									
X																									
Y																									
Z																									

PLACE MONUMENT SYMBOL (●) AT PROPER LOCATION ON ABOVE INDEX

EXAMPLE

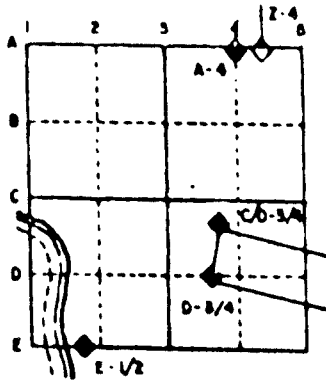

TURTLE TWP  
ROCK COUNTY WI

IF AVAILABLE  
STATE PLANE COORDINATES

North (Y) 216,792.51 Eleve. (Z) \_\_\_\_\_

East (X) 509,332.90 Zone \_\_\_\_\_

Hor. Datum COUNTY Vert. Datum \_\_\_\_\_

◆ CORNER MONUMENT

○ WITNESS MONUMENT

*Fd Poly MON.*

*Fd TIES IN N11*

BEARINGS ARE BASED ON:

SHEET \_\_\_ OF \_\_\_

CORNER CODE: N11(1)

(B) Describe any record evidence, monument evidence, occupational evidence, testimonial evidence or any other material evidence you considered, and whether the monument was found or placed.

1965 BATTERMAN VOL 4 PG 269 FOUND 2" PIPE & REFERENCED SAME.

1907 RUGER VOL 5 PG 322 FOUND OLD ORIGINAL STAKE HAD DECAYED & ANOTHER DECAYED STAKE. THE LATTER 17" N & 10" W OF ORIGINAL CORNER. SET AT ORIGINAL CORNER LS 26X7X6.5 SURROUNDED BY BRICKS. THE CORNER IS 28.71' EAST OF FENCE ON WEST SIDE OF ROAD & 32.34' WEST OF FENCE ON EAST SIDE OF ROAD & IT IS NWLY 153 1/2 TO ELM.

1986 BARNES VOL 6 PG 364 FOUND PIPE 2657.55 TO CENTER OF SEC 16 & 5322.08 TO N 1/4 COR SEC 16.

1986 BARNES N11 FOUND 2 1/2 PIPE. DROVE DEEP & PLACED POLY MONUMENT ON TOP. MONUMENT IS 2.5' NORTH & 4.2 EAST OF CENTER OF MANHOLE COVER.

FOUND POLY MONUMENT & TIES IN N11.

C) Was the corner restored through acceptance of (1) an obliterated evidence location, or, (2) a found perpetuated location?

ACCEPTED FOUND PERPETUATED LOCATION.

D) Describe any material discrepancy between the location of the corner as restored or reestablished and the location of that corner as previously restored or reestablished by distance and direction. Show the discrepancy on the plan view drawing under (a), above. Show the distances between the corner as previously restored or reestablished and (1) the corner as restored or reestablished, and (2) to at least 4 of the witness monuments shown on the drawing in (a), above.

(E) Was the corner reestablished through lost corner proportionate methods? If so, show the method, including the directions and distances to other public land survey corners used as evidence or used for proportioning the corner location.

NO

I, Donald Barnes, hereby certify that the corner points as identified by the corner code index were, in a field survey on, 1995, established, re-established, monumented, re-monumented, recovered or restored as expressed below and in conformance with the regulations and rules as required in the current manual of survey instructions of the United States Department of Interior, Bureau of Land Management.

seal

7/14/95

*Donald Barnes*

COUNTY SURVEYOR FILING DATA

Date of computer entry \_\_\_\_\_

Date microfilmed \_\_\_\_\_

Number of included sheets \_\_\_\_\_

CORNER CODE

EMBOSS LAND SURVEYOR SEAL

A-E 7.08 REQUIREMENT

N11 (1)