

U.S. PUBLIC LAND SURVEY MONUMENT RECORD

For Public Land Survey Corners in:

WI ADMINISTRATIVE CODE A-E 7.08 REQUIREMENT

T. / N., R. 13 E

CORNER CODE INDEX

TURTLE TWP

ROCK COUNTY WI

IF AVAILABLE
ROCK COUNTY COORDINATES PREFERRED

A	1	2	3	4	5	6	7	8	9	10	11	12	13	14	15	16	17	18	19	20	21	22	23	24	25
B																									
C	6				5					4				3							2				1
D																									
E																									
F																									
G	1				8					9				10							11				12
H																									
J																									
K																									
L	18				17					16				15							14				13
M																									
N																									
O																									
P	19				20					21				22							23				24
Q																									
R																									
S																									
T	30				29					28				27							26				25
U																									
V																									
W																									
X	31				32					33				34							35				36
Y																									
Z																									

North 205 985.71 Elev. _____
East 517, 296.24 MAY 2004
Hor. Datum _____ Vert. Datum _____
ADJUSTMENT

LATITUDE _____ ELLIPS. HT. _____

LONGITUDE _____

GPS (X) _____ TRAVERSE (X) _____

BASED ON THE FOLLOWING CONTROL:

PLACE MONUMENT SYMBOL AT PROPER LOCATION ON ABOVE INDEX

CORNER MONUMENT WITNESS MONUMENT

(a)

BEARINGS ARE BASED ON:

FIELD BOOK _____ PAGE # _____

SHEET 1 OF 3

SHOW A PLAN VIEW DRAWING DEPICTING THE CORNER MONUMENT AND SURROUNDING PHYSICAL FEATURES, INCLUDING THE EXCAVATION AREA AND DEPTH.

PLANNING & ZONING COMMITTEE ADOPTED THE ABOVE FORM ON 12/2/1982

CORNER CODE V-17(2)

TU609

(B) Describe any record evidence, monument evidence, occupational evidence, testimonial evidence or any other material evidence you considered, and whether the monument was found or placed.

- 1836 O. LYON APRIL EAST BETWEEN SECTIONS 26 & 35
5306.4 INTERSECTED N & S LINE 21.12' NORTH OF POST
LAND ROLLING & 2ND RAZTE TIMBER BLACK WHITE &
BUR OAK, UNDER GROWTH SAME
WEST CORRECTED BETWEEN SECTIONS 26 & 35
2653.2 SET QUARTER SECTION POST {BUR OAK 9 S69 1/2 W
50.16' BUR OAK 8 N35W 44.88'
5306.4 SECTION CORNER.
NORTH BETWEEN SECTIONS 34 & 35
1188 ENTERED MARSH
1980 LEFT MARSH
2125.2 B. OAK 5 INCHES IN DIAMETER
2443.32 BUR OAK 15 INCHES IN DIAMETER
2640 SET QUARTER SECTION POST {BUR OAK 22 N59E
69.3' BUR OAK 7 N52 1/2W 71.28'
5236.44 BUR OAK 17 INCHES IN DIAMETER
5280 SET POST CORNER TO SECTIONS 26,27,34,35 {BUR
OAK 14 S34W 23.1' BUR OAK 10 S77W 32.34'
LAND ROLLING & 2ND RATE TIMBER BUR & BLACK
OAK UNDERGROWTH SAME.
EAST RANDOM BETWEEN SECTIONS 27 & 34
3102 BROOK 3.3' WIDE RUNS SW
5230.5 INTERSECTED N & S LINE 1.32' NORTH OF POST
LAND ROLLING & 2ND RATE, TIMBER BUR & BLACK
OAK
WEST CORRECTED BETWEEN SECS 27 & 34
2615.25 SET QUARTER SECTION POST {BUR OAK 13 N28E
17.16' BUR OAK 16 N86W 59.4'
5230.5 SECTION CORNER
NORTH BETWEEN SECTIONS 26 & 27
990 BROOK 2.64' WIDE RUNS WEST
2640 SET QUARTER SECTION POST {BUR OAK 6 N88E
25.74' BUR OAK N65W 25.74'
4179.78 BUR OAK 4 INCHES IN DIAMETER
4897.86 B. OAK 16 INCHES IN DIAMETER
5280 SET POST CORNER TO SECTIONS 22,23,26 & 27 {B.
OAK 18 S21E B. OAK 13 N54E LAND ROLLING &
2ND RATE. TIMBER BUR & BLACK OAK UNDER
GROWTH OAK & GRASS.
1961 BATTERMAN VOL 4 PG 88 FD REMAINS OF WOOD STAKE.
RESET 1" PIPE. 2663.20 TO N 1/4 COR SEC 35 (SET 1" PIPE ON
LINE 1/2 BETWEEN NE & NW CORNERS SEC 35)
1968 BATTERMAN VOL 4 PG 376 2620.64 TO S 1/4 COR SEC 27 (SET
2" PIPE AT S 1/4 COR SEC 27)
1968 LEE CSM VOL 1 PG 203 FD 1" PIPE. NORTH 224.1' TO CENTER
OF RD
1995 BARNES V-17 FD 1" PIPE WITH CARSONITE POST. REF. SAME
N88-40-16W 2621.90 TO S 1/4 COR SEC 27, NO-06-08W
2654.02 TO E 1/4 COR SEC 27, S88-26-19E 2663.02 TO S 1/4
COR SEC 26, & S0-22-07E 2641.74 TO W 1/4 COR SEC 35.
1996 KREBS CSM VOL 19 PG 97 FD PIPE. 2654.00 TO E 1/4 COR SEC
27, 2662.98 TO S 1/4 COR SEC 26, NORTH 181.61 TO LOT COR
& S88-19-50E 293.23 TO LOT COR.
2000 KERBS MAP #07590 FD 1" PIPE
2003 BARNES V-17(1) & DOT MAPS #25122, 25268, & 25269
INFORMATION FROM WIDOT PROJECT SHEET #4.4 FD 1" IRON
PIPE Y=205,985.714; X=517,296.240 N00-06-07W 2654.02
TO E 1/4 COR SEC 27

May 19 2004
Donald Barnes

SHEET 1 OF 3
V-17(2)

TU609

FD 1" PIPE WITH CARSONITE. MONUMENT MAY BE DESTROYED BY MAJOR ROAD CONSTRUCTION JUST SOUTH OF THE COR.

C) Was the corner restored through acceptance of (1) an obliterated evidence location, or, (2) a found perpetuated location?

ACCEPTED FD PIPE WITH CARSONITE POST

D) Describe any material discrepancy between the location of the corner as restored or reestablished and the location of that corner as previously restored or reestablished by distance and direction. Show the discrepancy on the plan view drawing under (a), above. Show the distances between the corner as previously restored or reestablished and (1) the corner as restored or reestablished, and (2) to at least 4 of the witness monuments shown on the drawing in (a), above.

NONE

(E) Was the corner reestablished through lost corner proportionate methods? If so, show the method, including the directions and distances to other public land survey corners used as evidence or used for proportioning the corner location.

I, **Donald Barnes**, hereby certify that the corner location as identified by the corner code index was determined by me under my direction and control and that this U.S. Public Land Survey Monument Record is correct and complete to the best of my knowledge and belief.

May 19, 2004



Seal

Donald Barnes
Emboss

SHEET 2 OF 3


CORNER CODE **V-17(2)**

A.E. 7.08 REQUIREMENT

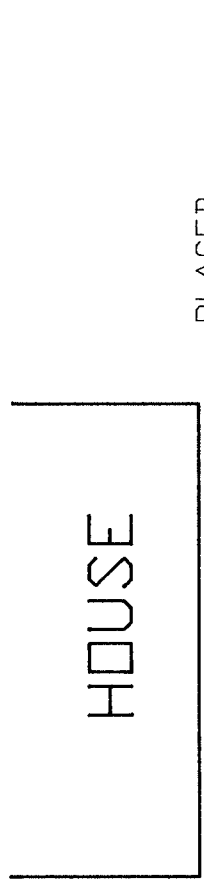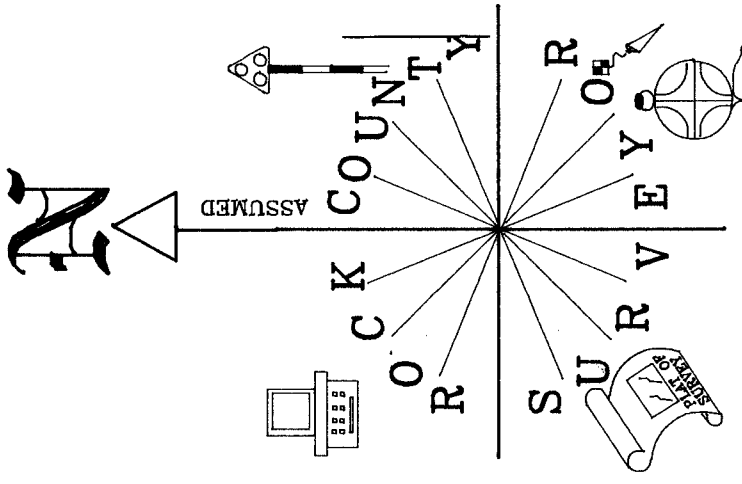

PLACED
○ 3/4X24" REROD
/ PLASTIC CAP

CORNER MAY BE DESTROYED
BY ROAD CONSTRUCTION

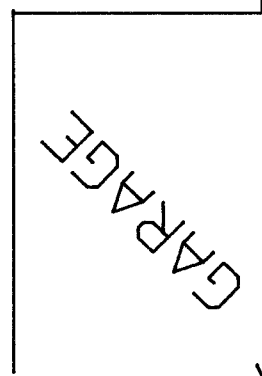

YARD

S80-23-58E 99.99

S64-28-54E 109.25

S74-15-08E 93.19

S70-46-04E 40.39

REC S76-43-50E 50.82

S76-54-40E 52.93

NW COR
SEC 35
TURTLE TWP
T1N R13E

14" TREE

REC 103.29

XXXXXXXXXXXXXXXXXXXX

FD 1" PIPE

NOT TO SCALE

OBSERVATION SHEET

EMBOSSED SEAL

SHEET 3 OF 3

May 19, 2004
Daryl Barnes

V-17(2)

FARM FIELD NEXT TO CARSONITE POST