
U.S.

SURVEY "UBLIC MONUMENT RECORD

For Public Land Survey Corners in the T. 1/11, R. 13 E

CORNER CODE INDEX

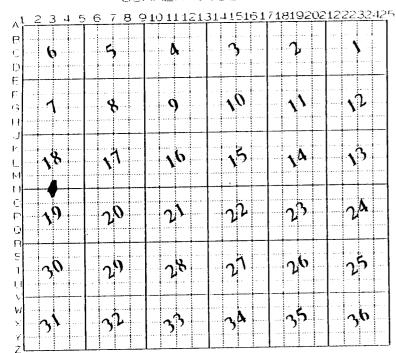

TWP TURTLE ROCK COUNTY WI

IF AVAILABLE ROCK COUNTY COORDINATES PERFERRED

Morth 216,867, 70 Elev.

East 498, 756.53

Hor. Datum COUNTY Vert. Datum

TRAVERSE (X) X GPS (X)

WPL 216,867,69

498,756.54

BASED ON THE FOLLOWING CONTROL:

PLACE MONUMENT SYMBOL & LOCATION ON ABOVE INDEX

CORNER MONUMENT

O WITHESS MONUMENT

(a)

BEARINGS ARE BASED ON:

PLANNING & ZONING COMMITTEE ADDRESS THE ABOVE FORM ON 12/2/1992 WI ADMINISTRATIVE CODE A-E 7.08 REQUIREMENT

SHEET ___OF _____

- (B) Describe any record evidence, monument evidence, occupational evidence, testimonial evidence or any other material evidence you considered, and whether the monument was found or placed.
- 1836 LYON EAST CORRECTED BETWEEN SECTIONS 18&19. BEARINGS {BURR OAK 18 S17E 476 & BUR OAK 6 N7E 266. CALLS FOR 2434.08 TO SW CORNER & 2640 TO SE CORNER OF SECTION 18.
- 1859 HOBART VOL 1 PG 105 2 LOCUST /6/5/17 USED TO SUBDIVIDE SECTION 19. 2424.18 W 1/4 TO CENTER OF SEC 19 & 2651.22 CENTER TO E 1/4 COR SEC 19.
- 1887 RUGER VOL 2 PG 414 SOUTH 2994.09 TO CENTER OF SHOPIERE & BELOIT RD & 5283.63 TO S 1/4 COR SEC 19. FOUND NE BT & WHERE STUMP OF SE BT HAD BEEN DUG UP. ALSO OLD FENCE POST HOLE. SET LIMESTONE 27X8X4 & SURROUNDED BY 4 LIMESTONES.
- 1911 KERCH VOL 3 PG 64 FOUND STONES SET BY RUGER SET BY RUGER FOR 1/4 SEC COR. 2136.9 TO 2" GAS PIPE AT CENTER OF ROAD & 2649.6 TO NE CORNER OF SECTION 19. ANGLE OF 89-14-30 AT NE CORNER OF SEC 19 FROM E 1/4 COR TO N 1/4 CORNERS OF SEC 19. ANGLE OF 90-32-40 AT NE CORNER OF SEC 19 FROM N 1/4 COR TO W 1/4 CORNER OF SECTION 20.
- 1911 KERCH VOL 3 PG 69 SET GAS PIPE IN PLACE OF STONE. 2438.4 TO NW CORNER OF SECTION 19 & AN ANGLE OF 89-13 AT CENTER OF SECTION OF 19 FROM N 1/4 COR TO E 1/4 CORNER OF SECTION 19.
- 19 FROM N 1/4 COR TO E 1/4 CORNER OF SECTION 19.
 1958 BATTERMAN VOL 3 PG 509 AN ANGLE OF 90-33-20 AT CENTER OF SECTION
 18 FROM E 1/4 TO S 1/4 CORNERS OF SECTION 18. 2658.80 FROM CENTER
 OF SECTION 18 TO S 1/4 CORNER OF SECTION 18.

COMPUTED ANGLE FROM N 1/4 TO E 1/4 CORNERS OF SECTION 19 AT THE INTERSECTION OF THE E/W & N/S QUARTER LINES IS 89-12-59. THE DISTANCE FROM THE N 1/4 TO THE NW CORNERS OF SECTION 19 IS 2439.42.

- C) Was the corner restored through acceptance of (1) an obliterated evidence location, or, (2) a found perpetuated location? FOUND 3/4" REROD. PLACED CARSONITE ON NORTH SIDE.
- D) Describe any material discrepancy between the location of the corner as restored or reestablished and the location of that corner as previously restored or reestablished by distance and direction. Show the discrepancy on the plan view drawing under (a), above. Show the distances between the corner as previously restored or reestablished and (1) the corner as restored or reestablished, and (2) to at least 4 of the witness monuments shown on the drawing in (a), above.
- (E) Was the corner reestablished through lost corner proportionate methods? If so, show the method, including the directions and distances to other public land survey corners used as evidence or used for proportioning the corner location.
- I, Donald Barnes, hereby certify that the corner points as identified by the corner code index were, in a field survey on, APRIL 9, 1992, established, re-established, monumented, re-monumented, recovered or restored as expressed below and in conformance with the regulations and rules as required in the current manual of survey instructions of the United States Department of Interior, Bureau of Land Management.

	COUNTY SURVEYOR FILING DATA
seal	Date of computer entry
7/14/95	Date microfilmed
1) weldbarres	Number of included sheets

EMBOSS LAND SURVEYOR SEAL