

U.S. PUBLIC LAND SURVEY MONUMENT RECORD


For Public Land Survey Corners in the
 Spring Valley T. 2 N., R. 10 E.

For Miscellaneous Corners within Sec.
 21, T. 2 N., R. 10 E.

CORNER CODE INDEX


	1	2	3	4	5	6	7	8	9	10	11	12	13	14	15	16	17	18	19	20	21	22	23	24	25	
A																										
B																										
C	6																									
D		5																								
E			4																							
F				3																						
G					2																					
H																										
I																										
J																										
K																										
L																										
M																										
N																										
O																										
P																										
Q																										
R																										
S																										
T																										
U																										
V																										
W																										
X																										
Y																										
Z																										

PLACE MONUMENT SYMBOL (◆) AT PROPER LOCATION ON ABOVE INDEX

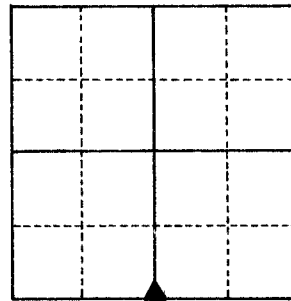

1. Above code numbers are positioned Meander, Claim, or Fractional corners of the section.
2. Township corner code numbers shall be applied to the corners of above typical section.

EXAMPLE

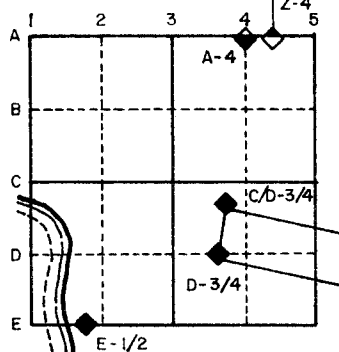


IF AVAILABLE
 STATE PLANE COORDINATES

North (Y) 224,876.0 Eleve. (Z) _____
 East (X) 2,183,869.7 Zone _____
 Hor. Datum _____ Vert. Datum _____

◆ CORNER MONUMENT
 TOP 2 SECTIONS
 OF POLY MON

○ WITNESS MONUMENT

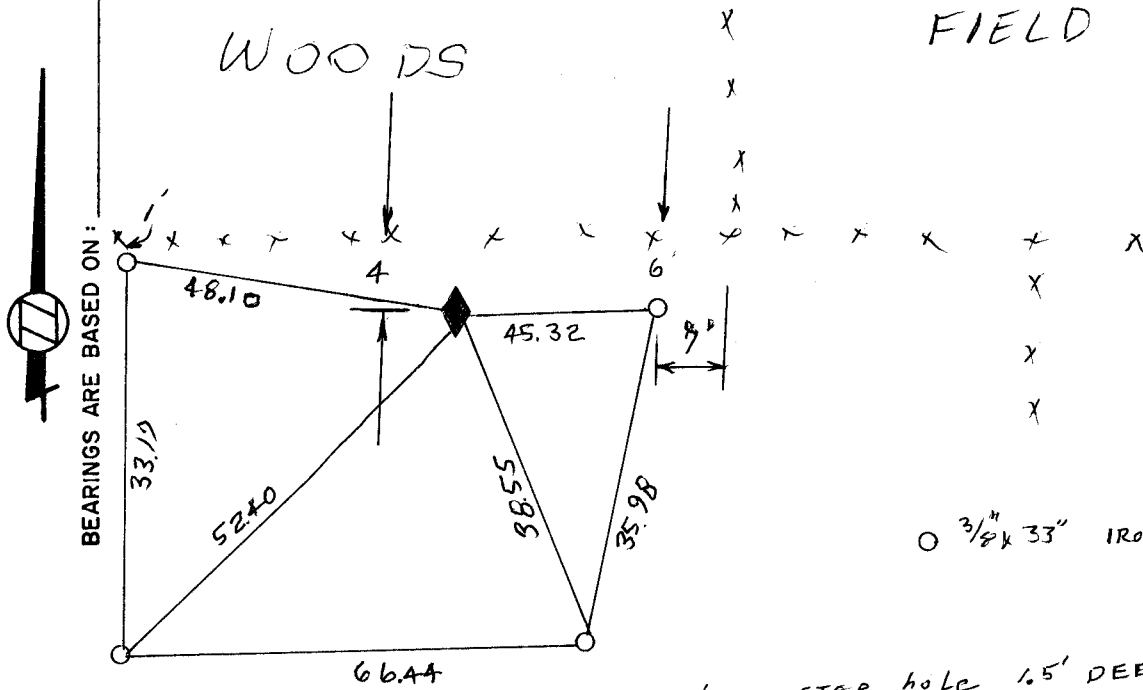

MICROFILMED

SHOW A PLAN VIEW DRAWING DEPICTING THE CORNER MONUMENT AND SURROUNDING PHYSICAL FEATURES, INCLUDING THE EXCAVATION AREA AND DEPTH. THE CORNER MONUMENT SHALL HAVE THE FOLLOWING CHARACTERISTICS: 1) HAVE AT LEAST TWO PREDETERMINED BREAK-OFF POINTS. 2) IF BROKEN, LEAVE A PERMANENTLY MAGNETIZED REMNANT AT THE ORIGINAL POINT. 3) MUST BE EXTENDABLE. 4) THE CAP IS INSCRIBED: ROCK COUNTY SURVEY MONUMENT - PENALTY FOR DISTURBING MARKER. 5) OR AN EXISTING CUT LIMESTONE. AN IRON PIPE 1 1/2" x 4'0" (MINIMUM) WITH AT LEAST 4 DURABLE WITNESS MONUMENTS MAY BE USED IN AREAS WHERE GROUND WATER IS WITHIN 1.0' OF THE SURFACE. IF THE CORNER IS OCCUPIED BY AN IMPROVEMENT (MANHOLE, BURIED CABLE, ETC.), ANY DURABLE, DISTINCT MONUMENT MAY BE USED AND REFERENCED WITH AT LEAST 4 DURABLE WITNESS MONUMENTS.

CORNER CODE: R-11

- Describe any record evidence, monument evidence, occupational evidence, testimonial evidence or any other material evidence you considered and whether the monument was found or set.

DUG SMALL HOLE AND FOUND NOTHING. SET CORNER ON LINE WITH THE S1/4 COR
OF SEC 28 AND THE E 1/16th CORNER OF THE NW 1/4 OF SECTION 28 AT PROPORTIONATE
MEASUREMENT. THIS DID NOT FIT WITH N/S FENCE, OR CHURCH'S RECORD MEASUREMENT
TO THE NE CORNER OF SECTION 28. AIRPHOTO INDICATED A DUAL N/S FENCE IN THE
NORTH HALF OF SECTION 21. I COULD NOT FIND A RECORD OF HOW THE SE CORNER OF
SECTION 21 WAS SET BY H. LEE.


- Describe any material discrepancy between the location of the corner as restored or re-established and the location of that corner as previously restored or re-established.

- Was the corner restored through acceptance of an obliterated evidence location or a found perpetuated location.

SET THROUGH ACCEPTANCE OF OBLITERATED EVIDENCE.

- Was the corner re-established through lost corner proportionate methods? If so, show the method, including directions and distances to other public land survey corners used as evidence or used for proportioning in determination of the corner location.

I, Donald Barnes, hereby certify that the corner points as identified by the corner code index were, in a field survey on Nov 24 1982, established, re-established, monumented, re-monumented, recovered or restored as expressed below and in conformance with the regulations and rules as required in the current manual of survey instructions of the United States Department of Interior, Bureau of Land Management.

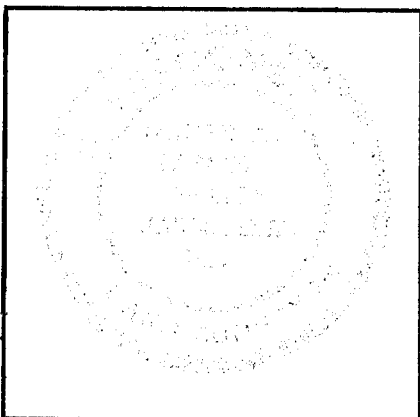

COUNTY SURVEYOR FILING DATA
 Date of Computer Entry _____
 Date Received _____
 Date Microfilmed _____
 Treasurer's Receipt No. _____
 Number of Included Sheets _____

AFFIX YOUR LAND SURVEYOR SEAL.