

Paper weight-110# (minimum)

Black nonfading ink required

U.S. PUBLIC LAND SURVEY MONUMENT RECORD

For Public Land Survey Corners In:

T. 2 N. R. 10 E. 4th P.M.

WI ADMINISTRATIVE CODE A-E 7.08 REQUIREMENT

REV 10/23/2004

USMONREC.DWG

CORNER CODE INDEX

A	1	2	3	4	5	6	7	8	9	10	11	12	13	14	15	16	17	18	19	20	21	22	23	24	25	A
B																										B
C	6																									C
D																										D
E																										E
F																										F
G	7																									G
H																										H
J																										J
K	18																									K
L																										L
M																										M
N																										N
O																										O
P	19																									P
Q																										Q
R																										R
S																										S
T	30																									T
U																										U
V																										V
W																										W
X	31																									X
Y																										Y
Z																										Z
	1	2	3	4	5	6	7	8	9	10	11	12	13	14	15	16	17	18	19	20	21	22	23	24	25	

PLACE MONUMENT SYMBOL \blacklozenge AT PROPER LOCATION ON ABOVE INDEX

SPRING VALLEY TWP

ROCK COUNTY WI

IF AVAILABLE

ROCK COUNTY COORDINATES PREFERRED

North _____ Elev. _____

East _____

Hor. Datum _____ Vert. Datum _____

LATITUDE _____ ELLIPS. HT. _____

LONGITUDE _____

NAD83(91) _____ NETWORK ADJ. YR _____

GPS (X) _____ TRAVERSE (X) _____

BASED ON THE FOLLOWING CONTROL:

\blacklozenge CORNER MONUMENT

\circ WITNESS MONUMENT

(a)


ROCK COUNTY COORDINATE SYSTEM

2007 ADJUSTMENT

BEARINGS ARE BASED ON:

SCALE: 1" = 40'

GRAPHIC BAR SCALE:

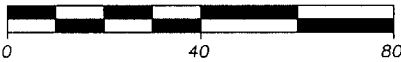

CULTIVATED

WEST CHURCH ROAD

CULTIVATED

SOUTH

DICKEY

ROAD

LEGEND:

\blacklozenge 3/4" X 24" solid round iron rod set, weighing 1.50 lbs per lined ft.

\circ 3/4" X 24" solid round iron rod set, weighing 1.50 lbs per lined ft.

E/P Edge of pavement.

WOODS

WOODS

Todd E. Hume

4-20-2011

FIELD BOOK _____ PAGE # _____

SHEET 1 OF 2

SHOW A PLAN VIEW DRAWING DEPICTING THE CORNER MONUMENT AND SURROUNDING PHYSICAL FEATURES, INCLUDING THE EXCAVATION AREA AND DEPTH.

PLANNING & ZONING COMMITTEE ADOPTED THIS FORM ON 12/2/1982

CORNER CODE T-11

(B) Describe any record evidence, monument evidence, occupational evidence, testimonial evidence or any other material evidence you considered, and whether the monument was found or placed.


I struggled with the location of the Center of Section, as County Surveyor Joseph Church performed work back in 4-8-1855, which would have located this corner by the Equal Distance Method and the Federal Method was used by Richard Talarczyk on 6-6-1996 and by Jason Houle on 4-14-2004. The Federal Method does not fit very well with existing physical evidence found in the Section. This corner location is assumed to have been previously established by Surveyor Clayton Shimeall, on 10-12-1970, as he had prepared a Certified Survey Map in the SW corner of Section 28, as Recorded in Volume 1 of Certified Survey Maps of Rock County, on Page 326. I found and accepted the location of an 8" barn spike, that I am assuming was set by Shimeall, as this spike was found online with the S 1/4 corner and the 1" iron pipes found on the east side of Shimealls Certified Survey Map.

C) Was the corner restored through acceptance of (1) an obliterated evidence location, or, (2) a found perpetuated location?

D) Describe any material discrepancy between the location of the corner as restored or reestablished and the location of that corner as previously restored or reestablished by distance and direction. Show the discrepancy on the plan view drawing under (a), above. Show the distances between the corner as previously restored or reestablished and (1) the corner as restored or reestablished, and (2) to at least 4 of the witness monuments shown on the drawing in (a), above.

This corner location was restored from acceptance of an 8" barn spike that I am assuming was set by Surveyor Clayton Shimeall, on 10-12-1970 and existing physical evidence as found within Section 28. Please refer to the Plat of Survey I have prepared for more information.

(E) Was the corner reestablished through lost corner proportionate methods? If so, show the method, including the directions and distances to other public land survey corners used as evidence or used for proportioning the corner location.

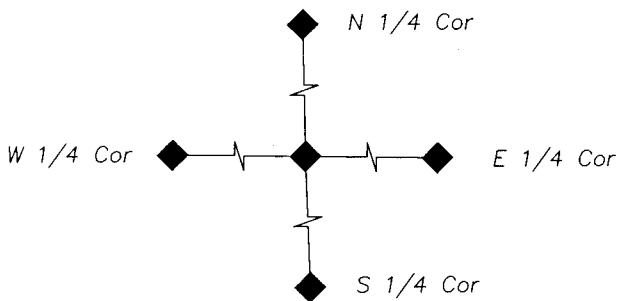

Center to E 1/4 = S89°05'10"E, 2649.76'
 Center to S 1/4 = S2°00'41"E, 2647.59'
 Center to W 1/4 = M89°21'04"W, 2638.04'
 Center to N 1/4 = N1°03'13"W, 2657.18'

I, **TODD E. HASSE** hereby certify that the corner location as identified by the corner code index was determined by me under my direction and control and that this U.S. Public Land Survey Monument Record is correct and complete to the best of my knowledge and belief.

Seal

Emboss

SHEET 2 OF 2

CORNER CODE T-11

A.E. 7.08 REQUIREMENT

Todd E. Hasse

4-20-2011