
U.S.

PUBLIC LAND SURVEY MONUMENT RECORD

For Public Land Survey Corners in: T. L.N., R. ___E

CORNER CODE INDEX

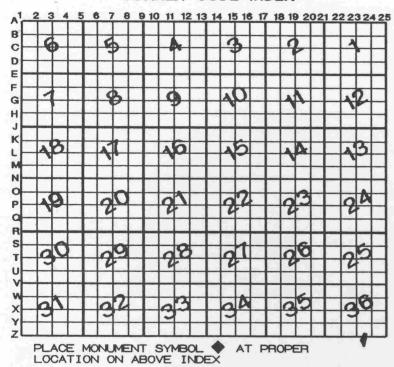

WI ADMINISTRATIVE CODE A-E 7.08 REQUIREMENT

TWE

ROCK COUNTY WI

IF AVAILABLE
ROCK COUNTY COORDINATES PERFERRED

North 201,039,58 Elev. ____

Hor. Datum COUNTY Vert. Datum

LATITUDE _____ELLIPS. HT.

LONGITUTE _____

GPS (X) __ TRAVERSE (X) __ BASED ON THE FOLLOWING CONTROL:

♦ CORNER MONUMENT

O WITNESS MONUMENT

BEARINGS ARE BASED ON:

(a)

	/
FIELD BOOKPAGE #	SHEET OF
SHOW A PLAN VIEW DRAWING DEPICTING THE CORNER MONUMENT	AND SURROUNDING
PHYSICAL FEATURES, INCLUDING THE EXCAVATION AREA AND DEPTH	
PLANNING & ZONING COMMITTEE ADOPTED THE ABOVE FORM ON 12/2/1982	

CORNER CODE 2 23/24

NW 4 4011 T46N R2E IL505R2

(B) Describe any record evidence, monument evidence, occupational evidence, testimonial evidence or any other material evidence you considered, and whether the monument was found or placed.

1836 SPALDING FIELD NOTES PAGE 396 ORIGINAL SURVEYOR.

NORTH BETWEEN 4 & 5 T46N R2E OF THE 3RD P.M. VARIATION 6-30 EAST 330 ENTER TURTLE RIVER BOTTOM BEARS NE & SW

2640 SET A RED ELM POST 6" DIAMETER AND 4' LONG 2' FEET IN
THE GROUND FOR QUARTER SECTION CORNER. THE GROUND

FROZEN. I CANNOT RAISE A MOUND AND I CANNOT GET A STONE, AND THERE ARE NO TREES WITHIN A HALF A MILE. LAND THE BOTTOM IS MOSTLY DRY RICH SOIL FIT FOR CULTIVATION. THE BLUFF BOTTOM IS ABOUT 40 FEET HIGH BUT

NOT STONE IN THE BANKS.

3825.36 INTERSECTED THE BASE LINE OF THE NW TERRITORY AND NORTH BOUNDARY OF ILLINOIS 498.3 EAST OF THE QUARTER SECTION CORNER ON THE SOUTH SIDE OF SECTION 36 T1N R12E OF THE 4TH P.M. AND AT SAID INTERSECTION SET A RED ELM POST 4 FEET LONG AND 8" DIAMETER 2 FEET IN THE GROUND FOR CORNER TO SECTIONS 4 & 5 T46N R2E OF THE 3RD P.M. I CAN NEITHER RAISE A MOUND GET A STONE, OR TAKE A BEARING TREE. LAND LEVEL RICH BOTTOM PRAIRIE FIT FOR CULTIVATION.

1838 SPAULDING (MAR 15) I SET A STONE ON THE WEST SIDE OF THE POST WHICH WAS SET FOR QUARTER SECTION CORNER IN THE LINE BETWEEN SECTIONS 4 & 5 T46N R2E SAID STONE IS 20 INCHES LONG 16 INCHES WIDE AND 6 INCHES THICK. IT IS SET 12 INCHES IN THE GROUND. EDGES FACING N & S. I THEN SET A STONE 20 INCHES LONG, 16 INCHES WIDE AND 6 INCHES THICK 12 INCHES IN THE GROUND. EDGES FACING E&W ON THE SOUTH SIDE OF THE POST WHICH WAS SET AT THE INTERSECTION OF THE LINE BETWEEN SECTIONS 4 & 5 WITH THE NORTH BOUNDARY OF THE STATE OF ILLINOIS FOR CORNER TO SECTIONS 4 & 5 T46N R2 EAST OF THE P.M.

192? TISSANDIER MAP 5370.70 TO NE COR SEC 4,5286.13 TO NW COR SEC 5 T46N R2E, & AN ANGLE OF 179-59-33 AT THE NW COR SEC 4 FROM THE NW COR SEC 5 TO THE NE COR SEC 4. LAT 42-30-19.44"; LONG 89-02-36.06"

FOUND STONE IN ROUND MON BOX 504.92 (REC 498.30) EAST OF THE S 1/4 COR SEC 36 T1N R12E.

- C) Was the corner restored through acceptance of (1) an obliterated evidence location, or, (2) a found perpetuated location?
 NEITHER ACCEPTED NOR REJECTED CORNER.
- D) Describe any material discrepancy between the location of the corner as restored or reestablished and the location of that corner as previously restored or reestablished by distance and direction. Show the discrepancy on the plan view drawing under (a), above. Show the distances between the corner as previously restored or reestablished and (1) the corner as restored or reestablished, and (2) to at least 4 of the witness monuments shown on the drawing in (a), above.
- I, Donald Barnes, hereby certify that the corner points as identified by the corner code index were, in a field survey, established, reestablished, monumented, re-monumented, recovered or restored as expressed below and in conformance with the regulations and rules as required in the current manual of survey instructions of the United States Department of Interior, Bureau of Land Management.

 COUNTY SURVEYOR FILING DATA

Ponall Bours OF 70 1998 EMBOSS LAND SURVEYOR SEAL

Number of included sheets CORNER CODE

7 23/24