
U.S.

PUBLIC LAND SURVEY MONUMENT RECORD

For Public Land Survey Corners in: T. \(\subseteq N., \) R. \(\subseteq Z \) E

CORNER CODE INDEX

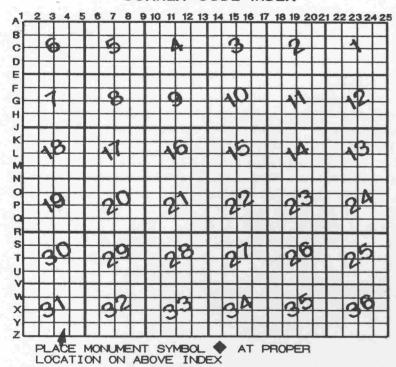

WI ADMINISTRATIVE CODE A-E 7.08 REQUIREMENT

TWP

ROCK COUNTY WI

IF AVAILABLE ROCK COUNTY COORDINATES PERFERRED

North 201, 333,75 Elev.

East 467, 583.87

Hor. Datum COUNTY Vert. Datum

LATITUDE _____ELLIPS. HT.

LONGITUTE

GPS (X) __ TRAVERSE (X) __

BASED ON THE FOLLOWING CONTROL:

♦ CORNER MONUMENT ○ WITNESS MONUMENT

BEARINGS ARE BASED

(a)

	/ /	
FIELD BOOKPAGE #	SHEET OF	
SHOW A PLAN VIEW DRAWING DEPICTING THE CORNER MONUMENT	AND SURROUNDING	
PHYSICAL FEATURES, INCLUDING THE EXCAVATION AREA AND DEPTH		
PLANNING & ZONING COMMITTEE ADOPTED THE ABOVE FORM ON 12/2/1982		

CORNER CODE 2 3

1114021

(B) Describe any record evidence, monument evidence, occupational evidence, testimonial evidence or any other material evidence you considered, and whether the monument was found or placed.

1836 SPAULDING JANUARY 11TH. ORIG SURVEY. INTERSECTING THE BASE LINE OF THE NORTH WEST TERRITORY AND NORTH BOUNDARY OF ILLINOIS 491.7'
EAST OF THE QUARTER SECTION CORNER ON THE SOUTH BOUNDARY OF
SECTION 31 TIN R12E OF THE 4TH PRINCIPLE MERIDIAN AND AT SAID INTERSECTION SET A POST FOR CORNER TO SECTIONS 3 & 4 T46N R1E OF THE 3RD PRINCIPLE MERIDIAN FROM WHICH POST A BLACK OAK 12"
DIAMETER BEARS S45-30W 47.52' AND A BLACK OAK 15 DIAMETER BEARS S44-30E 42.9' DISTANT. CALLS FOR 1974.06' TO THE W 1/4 COR SEC 3.

AT W 1/4 COR SEC 3 SET A POST FOR 1/4 COR IN WET GROUND .

192? TISSANDIER PLACED CONCRETE MONUMENT WITH BRASS PLUG. DROVE I.P.
BY MONUMENT. LAT 42-30-23.5 LONG 89-08-29.48. 5259.30 TO NW COR0
SEC 4,5220.00 TO NE COR SEC 3, AN ANGLE OF 179-55-20 (CLOCKWISE)
FROM NW COR SEC 4 TO NE COR SEC 3.

FOUND CONCRETE MONUMENT WITH BRASS PLUG 0.3' ABOVE GRAVEL DRIVE AND ON EAST SIDE OF DRIVEWAY. THE FOLLOWING WERE MEASURED: 501.80 (492.36 REC) TO S 1/4 COR SEC 31,& 5218.14 (5220.00 REC) TO NE COR SEC 3.

- C) Was the corner restored through acceptance of (1) an obliterated evidence location, or, (2) a found perpetuated location? DID NOT REJECT NOR ACCEPT FOUND LOCATION.
- D) Describe any material discrepancy between the location of the corner as restored or reestablished and the location of that corner as previously restored or reestablished by distance and direction. Show the discrepancy on the plan view drawing under (a), above. Show the distances between the corner as previously restored or reestablished and (1) the corner as restored or reestablished, and (2) to at least 4 of the witness monuments shown on the drawing in (a), above.
- (E) Was the corner reestablished through lost corner proportionate methods? If so, show the method, including the directions and distances to other public land survey corners used as evidence or used for proportioning the corner location.
- I, Donald Barnes, hereby certify that the corner points as identified by the corner code index were, in a field survey on, established, reestablished, monumented, re-monumented, recovered or restored as expressed below and in conformance with the regulations and rules as required in the current manual of survey instructions of the United States Department of Interior, Bureau of Land Management.

Donald Barnes Oct 20, 1998

COUNTY SURVEYOR FILING DATA

Date of computer entry____

Date microfilmed _____

Number of included sheets

EMBOSS LAND SURVEYOR SEAL

A-E 7.08 REQUIREMENT

CORNER CODE 3/4