
aper weight- 32# 25% Rag Ledger (minimum)

Black nonfading ink required

SURVEY UBLIC MONUMENT RECORD

For Public Land Survey Corners in the T. LN., R. 13_E

CORMER CODE INDEX

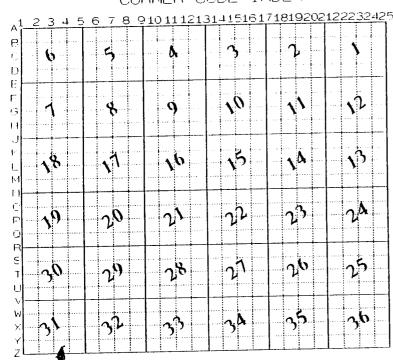

TURTLE ROCK COUNTY WI

IF AVAILABLE BOOK COUNTY COORDINATES PERFERENCE

The second secon
North Elev.
East
Hor. Datum Vert. Datum
GPS (X) TRAVERSE (X) BASED ON THE FOLLOWING CONTROL:

PLACE MONUMENT SYMBOL & LOCATION OF ABOVE INDEX AT PROPER

CORNER MONUMENT

O WITHESS MONUMENT

BEARINGS ARE BASED ON:

(a)

FIELD BOOK PAGE #

SHOW A PLAN VIEW DRAWLING DEPICTING THE CORNER MONDERN AND SUPRIGIDING DAYSICAL FEATURES, INCLUDING THE EXCAVATION AREA AND DEPTH. THE CORNER MONDERN AND SUPRIGIDING DAYSICAL FEATURES, INCLUDING THE EXCAVATION AREA AND DEPTH. THE ORIGINAL POINT THE FOLLOWING CHARACTERISTICS: 1) HAVE A LEAST TWO PREDETERMINED BREAK-COFF POINTS. 21 IF BROKET LEAVE A PERFIMENTLY MAGNETIZED REMAINT AT THE ORIGINAL POINT OF SUBJECT OF AN EXISTING CUT LIMESTONE. AN IRAN PIPE 1 1/2"Y AND THE EXTENDED. 4" THE CAP IS INSCRIBED TROKE COUNTY SURVEY MONDERIT - PENALTY FOR DISTURBING MARKET. 51 OR AN EXISTING CUT LIMESTONE. AN IRAN PIPE 1 1/2"Y A MUST BE EXTENDED. 4" INTINITION MAY BE USED IT! AREAS MERE GROUND WATER IS NOT THE STATE OF THE CORNER IS DOCUMENT OF THE SURVEY MAY BE USED IT! AREAS MERE GROUND WATER IS NOT THE STATE OF THE SHEET _ _ OF _ ____

FLAFFIELD & ZONIERD GOMMITTEE ADOPTED THE ABOVE FORM ON 12/2/1982 WI ADMINISTRATIVE CODE A-E 7.08 REQUIREMENT

corner code 2 3/4

NW 3 4001 ILL507R2

(B) Describe any record evidence, monument evidence, occupational evidence, testimonial evidence or any other material evidence you considered, and whether the monument was found or placed.

1838 SPALDING FIELD NOTES PG 390 & 391. INTERSECTED BASE LINE OF NORTH WEST TERRITORY & NORTH BOUNDARY OF ILL. 2052.6' WEST OF COR TO SEC 31 & 32 T1N R13E OF 4TH PM AT SAID INTERSECTION SET A POST & STONE 14" LONG 8" WIDE & 6" THICK FOR CORNER TO SEC 3 & 4 T46N R2E OF 3 P.M. ORIGINAL PLAT CALLS FOR 2052.60.

- 192? TISSANDIER MAP 5367.70 TO NE COR SEC 3, 5370.70 TO NW COR SEC 4, & AN ANGLE OF 179-58-12 AT THE NW COR SEC 3 FROM THE NE COR SEC 3 TO THE NW COR SEC 4. LAT 42-30-18.72"; LONG 89-01-24.36"
- Was the corner restored through acceptance of (1) an obliterated evidence location, or, (2) a found perpetuated location?
- Describe any material discrepancy between the location of the corner as restored or reestablished and the location of that corner as previously restored or reestablished by distance and direction. Show the discrepancy on the plan view drawing under (a), above. Show the distances between the corner as previously restored or reestablished Show the and (1) the corner as restored or reestablished, and (2) to at least 4 of the witness monuments shown on the drawing in (a), above.
- Was the corner reestablished through lost corner proportionate methods? If so, show the method, including the directions and distances to other public land survey corners used as evidence or used for proportioning the corner location.

I, Donald Barnes, hereby certify that the corner points as identified r ϵ r

by the corner code index were, in a field survey on,	
re-established, monumented, re-monumented, recovered or	restored as
expressed below and in conformance with the regulations	and rules as
required in the current manual of survey instructions of	
States Department of Interior, Bureau of Land Management	t.

seal

EMBOSS LAND SURVEYOR SEAL

COUNTY SURVEYOR FILING DATA Date of computer entry Date microfilmed Number of included sheets CORNER CODE

ILLINOIS ORIGINAL GOVERNMENT FIELD NOTES T46N R2&3E CERTIFICATE DEC 29,1836

D.A. SPAULDING
WILLIAM TOP
JAMES THOMAS
R. WALLER
HENRY CHANDLER

DL CH CHAINMAN CHAINMAN FLAGMAN AXE MAN

ALL CORNER POSTS WERE INSERTED 2' INTO A HOLE DUG IN THE GROUND WITH AN AXE & SPADE THROUGH THE FROST & THEY WERE SECURELY RAMMED IN WITH EARTH. THE STONES USED FOR CORNERS WERE OBTAINED AT DIFFERENT QUARRIES IN THE ?? AND WERE SET 1 1/2 THEIR LENGTH IN THE GROUND & ON ALL THE N/S LINES, THEY WERE SET THE WEST SIDE OF THE POSTS & EDGES FACING N/S AND ON THE E/W LINES THEY WERE SET THE NORTH SIDE OF THE POSTS & EDGES FACING E & W.

THE SAID POSTS WERE OF THE MOST DURABLE WOOD THAT COULD BE HAD IN THE LAND GENERALLY BURR OAK. THE SECTION POSTS WERE 5' LONG & WERE NOT LESS THAN 5" IN DIA., THAT THEY WERE NEATLY SQUARED AT TOP & THEN PLACED WITH THE CORNERS TO THE CARDINAL POINTS. (CONTINUES WITH OTHER STATEMENTS).

PAGE 857. DEC 26, 1838 MEASURED CHAIN COMPARED WITH THE STANDARD CHAIN & LIST IT TO BE A HALF INCH TOO LONG. MAKE IT OF THE PROPER LENGTH.

7-3/4