

# U.S. PUBLIC LAND SURVEY MONUMENT RECORD


For Public Land Survey Corners in the  
T. 1 N., R. 12 E.

## CORNER CODE INDEX

|   |    |   |   |   |   |   |   |   |   |    |    |    |    |    |    |    |    |    |    |    |    |    |    |    |    |
|---|----|---|---|---|---|---|---|---|---|----|----|----|----|----|----|----|----|----|----|----|----|----|----|----|----|
|   | 1  | 2 | 3 | 4 | 5 | 6 | 7 | 8 | 9 | 10 | 11 | 12 | 13 | 14 | 15 | 16 | 17 | 18 | 19 | 20 | 21 | 22 | 23 | 24 | 25 |
| A |    |   |   |   |   |   |   |   |   |    |    |    |    |    |    |    |    |    |    |    |    |    |    |    |    |
| B |    |   |   |   |   |   |   |   |   |    |    |    |    |    |    |    |    |    |    |    |    |    |    |    |    |
| C | 6  |   |   |   |   |   |   |   |   |    |    |    |    |    |    |    |    |    |    |    |    |    |    |    |    |
| D |    |   |   |   |   |   |   |   |   |    |    |    |    |    |    |    |    |    |    |    |    |    |    |    |    |
| E |    |   |   |   |   |   |   |   |   |    |    |    |    |    |    |    |    |    |    |    |    |    |    |    |    |
| F |    |   |   |   |   |   |   |   |   |    |    |    |    |    |    |    |    |    |    |    |    |    |    |    |    |
| G |    |   |   |   |   |   |   |   |   |    |    |    |    |    |    |    |    |    |    |    |    |    |    |    |    |
| H | 7  |   |   |   |   |   |   |   |   |    |    |    |    |    |    |    |    |    |    |    |    |    |    |    |    |
| I |    |   |   |   |   |   |   |   |   |    |    |    |    |    |    |    |    |    |    |    |    |    |    |    |    |
| J |    |   |   |   |   |   |   |   |   |    |    |    |    |    |    |    |    |    |    |    |    |    |    |    |    |
| K |    |   |   |   |   |   |   |   |   |    |    |    |    |    |    |    |    |    |    |    |    |    |    |    |    |
| L | 18 |   |   |   |   |   |   |   |   |    |    |    |    |    |    |    |    |    |    |    |    |    |    |    |    |
| M |    |   |   |   |   |   |   |   |   |    |    |    |    |    |    |    |    |    |    |    |    |    |    |    |    |
| N |    |   |   |   |   |   |   |   |   |    |    |    |    |    |    |    |    |    |    |    |    |    |    |    |    |
| O |    |   |   |   |   |   |   |   |   |    |    |    |    |    |    |    |    |    |    |    |    |    |    |    |    |
| P | 19 |   |   |   |   |   |   |   |   |    |    |    |    |    |    |    |    |    |    |    |    |    |    |    |    |
| Q |    |   |   |   |   |   |   |   |   |    |    |    |    |    |    |    |    |    |    |    |    |    |    |    |    |
| R |    |   |   |   |   |   |   |   |   |    |    |    |    |    |    |    |    |    |    |    |    |    |    |    |    |
| S |    |   |   |   |   |   |   |   |   |    |    |    |    |    |    |    |    |    |    |    |    |    |    |    |    |
| T | 30 |   |   |   |   |   |   |   |   |    |    |    |    |    |    |    |    |    |    |    |    |    |    |    |    |
| U |    |   |   |   |   |   |   |   |   |    |    |    |    |    |    |    |    |    |    |    |    |    |    |    |    |
| V |    |   |   |   |   |   |   |   |   |    |    |    |    |    |    |    |    |    |    |    |    |    |    |    |    |
| W |    |   |   |   |   |   |   |   |   |    |    |    |    |    |    |    |    |    |    |    |    |    |    |    |    |
| X | 31 |   |   |   |   |   |   |   |   |    |    |    |    |    |    |    |    |    |    |    |    |    |    |    |    |
| Y |    |   |   |   |   |   |   |   |   |    |    |    |    |    |    |    |    |    |    |    |    |    |    |    |    |
| Z |    |   |   |   |   |   |   |   |   |    |    |    |    |    |    |    |    |    |    |    |    |    |    |    |    |

PLACE MONUMENT SYMBOL (◆) AT PROPER LOCATION ON ABOVE INDEX

### EXAMPLE

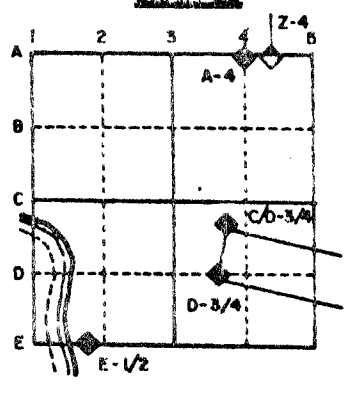

BELOIT TWP  
ROCK COUNTY WI

IF AVAILABLE  
STATE PLANE COORDINATES

North (Y) \_\_\_\_\_ Eleve. (Z) \_\_\_\_\_  
 East (X) \_\_\_\_\_ Zone \_\_\_\_\_  
 Hor. Datum \_\_\_\_\_ Vert. Datum \_\_\_\_\_

◆ CORNER MONUMENT      ○ WITNESS MONUMENT

SEE OTHER SIDE


SHEET \_\_\_ OF \_\_\_

CORNER CODE A-18


BEARINGS ARE BASED ON:

**MICROFILMED**

|  |                        |                      |
|--|------------------------|----------------------|
| COUNTY<br><i>Rock</i>  |                        |                      |
| TOWN<br><i>of Beloit</i>   |                        |                      |
| HIGHWAY<br><i>Townline Road</i>  |                        |                      |
| SECTION<br><i>2</i>  | TOWNSHIP<br><i>1 N</i> | RANGE<br><i>12 E</i> |
| TYPE OF LANDMARKS<br>① <i>Witness</i><br><i>Brass Cap Cone Monuments</i> |                        |                      |

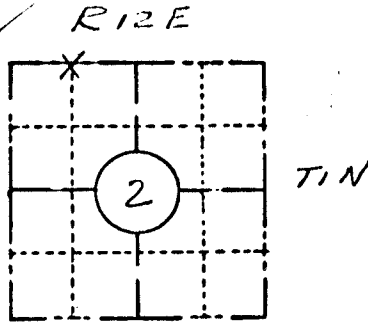


**LOCATION SKETCH**  
 (Location of landmark indicated by "x")

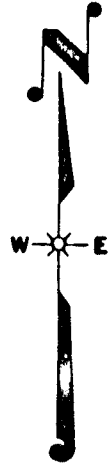

This space for copy of field notes or ties to the above described landmarks

*Note: All measurements from witness monuments to landmark were taken to original plat locate, in the old pavement, prior to grading operations on or about April 21, 1967*

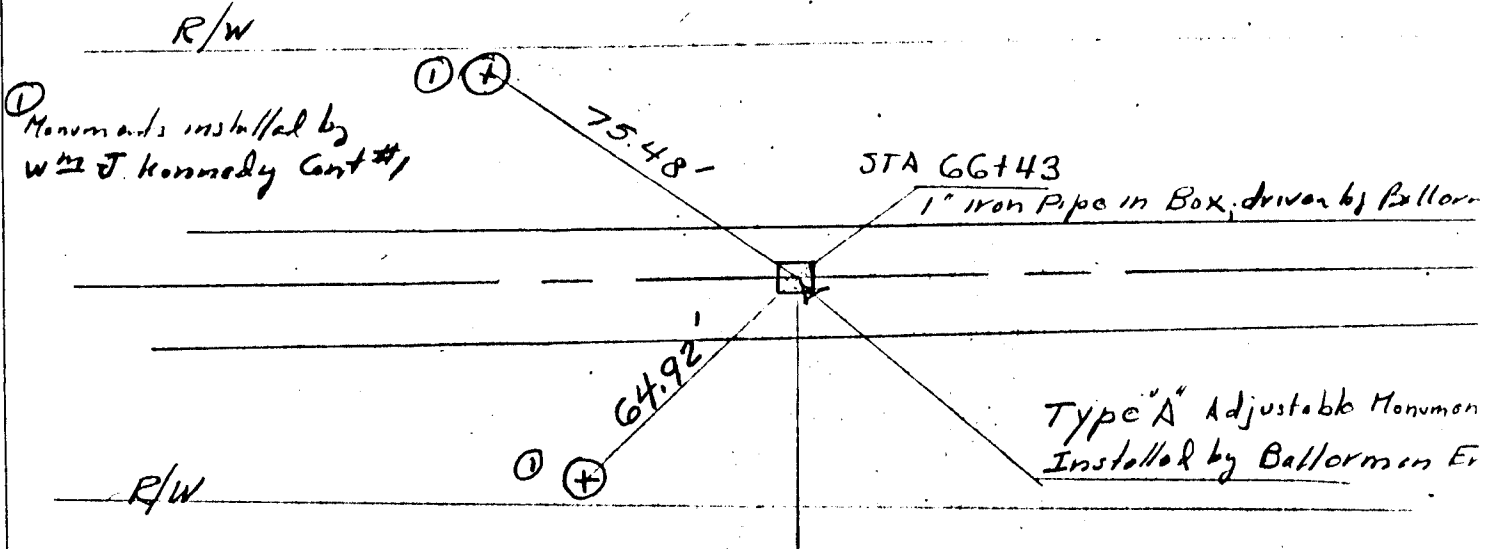

|  |                        |                       |
|--|------------------------|-----------------------|
| FILED UNDER PROJECT<br>NUMBER <i>50626(S)</i>  |                        |                       |
| SBC DISTRICT OFFICE<br>NUMBER <i>ONE</i>   | CITY<br><i>MADISON</i> | COUNTY<br><i>DANE</i> |
| LOCATED OR ESTABLISHED BY<br>NAME <i>O. Ikoski</i><br>TITLE <i>Pc. Eng.</i> DATE _____ |                        |                       |

|   |  |
|---|--|
| COUNTY CLERK'S OFFICE<br>COUNTY OF <b>WISCONSIN</b> |  |
| DATE RECEIVED FOR RECORD                            | DATE COPY SENT TO COUNTY SURVEYOR<br><i>12/20/65</i> |
| SIGNATURE OF COUNTY CLERK                           |  |

A-18