

U.S. PUBLIC LAND SURVEY MONUMENT RECORD

For Public Land Survey Corners in:

WI ADMINISTRATIVE CODE A-E 7.08 REQUIREMENT

T. 1N., R. 2E

CORNER CODE INDEX

BELOIT TWP

ROCK COUNTY WI

IF AVAILABLE
ROCK COUNTY COORDINATES PREFERRED

A	1	2	3	4	5	6	7	8	9	10	11	12	13	14	15	16	17	18	19	20	21	22	23	24	25
B																									
C	6																								
D		5																							
E																									
F	1	8																							
G			9																						
H																									
J																									
K	18	17	16																						
L																									
M																									
N																									
O																									
P	19	20	21																						
Q																									
R																									
S	30	29	28																						
T																									
U																									
V																									
W																									
X	31	32	33																						
Y																									
Z																									

North 214,470.52 Elev. _____

East 475,032.65

Hor. Datum COUNTY Vert. Datum _____

LATITUDE _____ ELLIPS. HT. _____

LONGITUDE _____

GPS (X) _____ TRAVERSE (X) _____

BASED ON THE FOLLOWING CONTROL:

PLACE MONUMENT SYMBOL AT PROPER LOCATION ON ABOVE INDEX

CORNER MONUMENT

WITNESS MONUMENT

(a)

BEARINGS ARE BASED ON:

FIELD BOOK _____ PAGE # _____

SHEET 1 OF 2

SHOW A PLAN VIEW DRAWING DEPICTING THE CORNER MONUMENT AND SURROUNDING PHYSICAL FEATURES, INCLUDING THE EXCAVATION AREA AND DEPTH.

PLANNING & ZONING COMMITTEE ADOPTED THE ABOVE FORM ON 12/2/1982

CORNER CODE P-9

BE576

(B) Describe any record evidence, monument evidence, occupational evidence, testimonial evidence or any other material evidence you considered, and whether the monument was found or placed.

1834 HARRISON ORIGINAL SURVEYOR.

NORTH BETWEEN SECS 20 & 21

343.2 BURR OAK 18

1320 LEFT TIMBER & ENTER PRAIRIE

1980 ENTER CREEK BOTTOM

2640 BROOK 5.28' CROSSES S.W.

3300 LEFT BOTTOM BEARING S.W.

2640 COR TO SECS 16,17,20 & 21 ON GROUND DESCENDING E. SET POST & RAISED MOUND LAND FOR 1ST 20 CHS SAME AS LATTER PART OF LAST NORTHING. RUN OF ? & WET 2ND RATE PRAIRIE- MOSTLY CREEK BOTTOM.

1859 RUGER VOL 6 PG 213 SURROUNDED 1/4 POST BY 4 LS 2651.22 TO SE COR SEC 20, 2674.49 TO CENTER OF SEC 20, 5348.97 TO W 1/4 COR SEC 20.

1859 RUGER VOL 1 PG 95 5349.3 TO W 1/4 COR SEC 20 & 2674.65 TO CENTER SEC 20.

1859 RUGER VOL 1 PG 96 SURROUNDED 1/4 POST 4 HH STONES, 2651.22 VAR 7-03 TO SW COR SEC 21, 2650.56 VAR 6-26 TO CENTER OF SEC 21, 5301.12 TO E 1/4 COR SEC 21, & CENTER SEC 21 TO E 1/4 COR SEC 21 VAR 6-26.

1943 BATTERMAN MAP #446 ANGLE OF 90-08-40 @ CENTER SEC 21 FROM S 1/4 TO W 1/4 COR SEC 21 & 1331.15 FROM CENTER 21 TO S 1/16TH OF NW 1/4 SEC 21.

1949 BATTERMAN MAP #43619 ANGLE OF 89-52 AT CENTER OF SEC 21 FROM W 1/4 COR TO N 1/4 CORNERS SEC 21.

1984 LEUENBERGER CSM V 11 PG 566 FOUND CONCRETE MONUMENT 1323.22 TO W 1/16TH COR OF THE NW 1/4 OR SEC 21

1989 LEE MAP #12137 FOUND CONCRETE MONUMENT

1989 KREBS MAP #12151 FOUND CONCRETE MONUMENT 2652.83 TO SE COR SEC 20, 1330.31 TO S 1/16TH COR OF NW 1/4 SEC 21.

1989 LEE MAP #12148 1340.52 TO S 1/16TH COR OF NE 1/4 SEC 20, 1323.27 TO E 1/16TH COR OF NE 1/4, ANGLE OF 88-53-02 FROM CENTER SEC 20 TO NE COR SEC 20.

FOUND CONCRETE MONUMENT WITH DISK.

C) Was the corner restored through acceptance of (1) an obliterated evidence location, or, (2) a found perpetuated location?
ACCEPTED FOUND LOCATION.

D) Describe any material discrepancy between the location of the corner as restored or reestablished and the location of that corner as previously restored or reestablished by distance and direction. Show the discrepancy on the plan view drawing under (a), above. Show the distances between the corner as previously restored or reestablished and (1) the corner as restored or reestablished, and (2) to at least 4 of the witness monuments shown on the drawing in (a), above.

(E) Was the corner reestablished through lost corner proportionate methods? If so, show the method, including the directions and distances to other public land survey corners used as evidence or used for proportioning the corner location.
NO

I, Donald Barnes, hereby certify that the corner points as identified by the corner code index were, in a field survey on, established, re-established, monumented, re-monumented, recovered or restored as expressed below and in conformance with the regulations and rules as required in the current manual of survey instructions of the United States Department of Interior, Bureau of Land Management.

Donald Barnes
seal
OCT 19 1998

COUNTY SURVEYOR FILING DATA

Number of included sheets _____
CORNER CODE P-9

EMBOSS LAND SURVEYOR SEAL

A-E 7.08 REQUIREMENT

NE COR
SEC 20
FD 1" PIPE
IN MON. BOX

CTH Q

S62-41-31E 3004.34

STA #15
FD T-BAR
17 +/- WEST OF
CENTER PVMT,
86 +/- NORTH OF
CENTER OF DR. TO
HSE ON EAST SIDE
OF RD.

STH 213

N64-30-24E 2946.49

FD DISK IN CONC.

E 1/4 COR
SEC 20

OCT 19, 1998
Donald Barnes

S9-55-37E 2711.28

SE COR
SEC 20

S55-21-23E 1589.16


XXXXXXXXXX

N31-54-34E 2558.16

STA #222 3/4X24 REROD
13.5' WEST OF N/S
FENCE; 94 +/- NORTH OF U.P.

OBSERVATION SHEET #222

SPRING CREEK RD

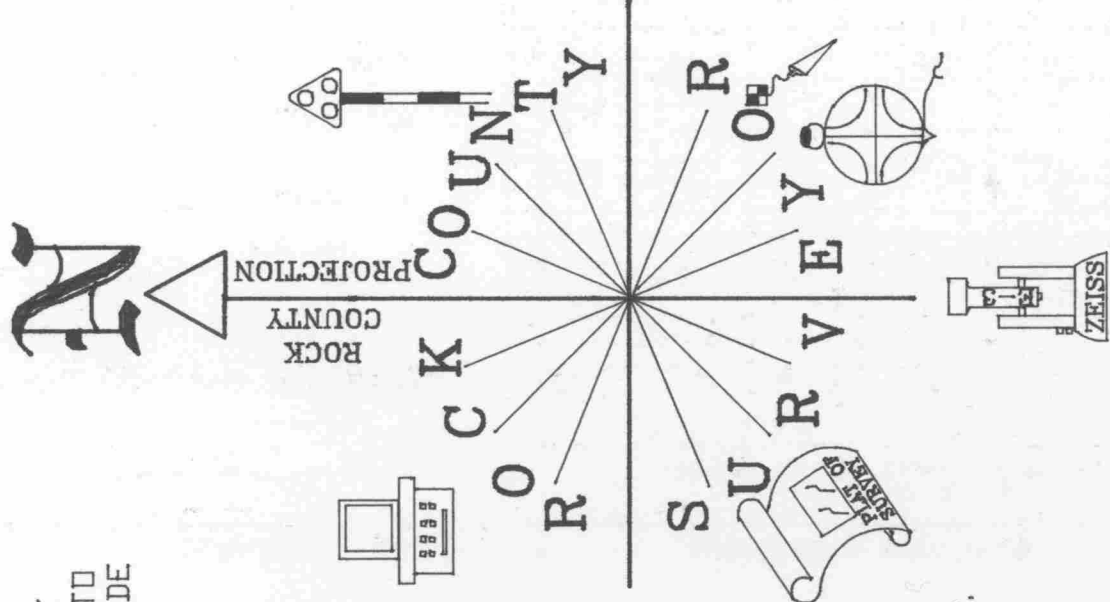

P - [Handwritten scribble]

P - [Handwritten scribble]