

# U.S. PUBLIC LAND SURVEY MONUMENT RECORD

For Public Land Survey Corners in:

WI ADMINISTRATIVE CODE A-E 7.08 REQUIREMENT

T. 1 N., R. 12 E

### CORNER CODE INDEX

1	2	3	4	5	6	7	8	9	10	11	12	13	14	15	16	17	18	19	20	21	22	23	24	25
A																								
B	6																							
C		5																						
D			4																					
E				3																				
F					2																			
G						1																		
H	1																							
I		8																						
J			9																					
K				10																				
L					11																			
M						12																		
N							13																	
O								14																
P									15															
Q										16														
R											17													
S												18												
T													19											
U														20										
V															21									
W																22								
X																	23							
Y																		24						
Z																			25					

BELoit TWP  
ROCK COUNTY WI

IF AVAILABLE  
ROCK COUNTY COORDINATES PREFERRED

North 206,471.01 Elev. \_\_\_\_\_

East 488,162.80

Hor. Datum COUNTY Vert. Datum \_\_\_\_\_

LATITUDE \_\_\_\_\_ ELLIPS. HT. \_\_\_\_\_

LONGITUDE \_\_\_\_\_

GPS (X) \_\_\_\_\_ TRAVERSE (X) \_\_\_\_\_

BASED ON THE FOLLOWING CONTROL:

PLACE MONUMENT SYMBOL  AT PROPER LOCATION ON ABOVE INDEX

CORNER MONUMENT

WITNESS MONUMENT

(a)

BEARINGS ARE BASED ON:

FIELD BOOK \_\_\_\_\_ PAGE # \_\_\_\_\_

SHEET 1 OF 3

SHOW A PLAN VIEW DRAWING DEPICTING THE CORNER MONUMENT AND SURROUNDING PHYSICAL FEATURES, INCLUDING THE EXCAVATION AREA AND DEPTH.

PLANNING & ZONING COMMITTEE ADOPTED THE ABOVE FORM ON 12/2/1982

CORNER CODE V 19

be610

(B) Describe any record evidence, monument evidence, occupational evidence, testimonial evidence or any other material evidence you considered, and whether the monument was found or placed.

- 1834 HARRISON EAST BETWEEN SECTIONS 26 & 35  
2640' SET POST FOR COR TO QUARTER SECTION NEAR WESTERN  
EDGE OF RIVER BOTTOM. RAISED A MOUND.  
3432' TO A TRAIL CRS S.W AND ENTER SMALL & SCAT. BURR O.  
TIMBER.  
4070.22' INT. RIGHT BANK OF ROCK RIVER CRS WEST OF SOUTH -  
SET A MEANDER POST. MARKED BURR OAK 14 S88W 97,  
BURR OAK 10 N32E 32
- 1848 MEPER "NOGGLES ADDITION TO BELOIT" BK 2 PG 5&6  
"AT THE 1/4 SECTION MOUND FOR WHICH THERE ARE ERRONEOUSLY  
BEARING TREES GIVEN IN THE GOVERNMENT FIELD NOTES IS BURIED  
4" INCHES BELOW THE SURFACE A LARGE ROUGH STONE 10" THICK  
WITH A BROKEN FACE TO THE NORTH AND AN ANGLE TO THE EAST."
- 1849 MESSER SUBDIVISION "MERRILS ADD" BK 2 PG 7. CALLS FOR COR  
33 NORTH OF SOUTH ROW LINE OF LIBERTY ST. & 33 WEST OF EAST  
ROW LINE OF WALKER ST. 1498.79 TO WEST EDGE OF ROCK RIVER.  
COR IS A BLOCK OF CREAM COLORED, STRATIFIED LIMESTONE,  
BURIED WITH THEIR UPPER SIDES FROM 8 TO 12 INCHES BELOW THE  
SURFACE OF THE GROUND IN WHICH ARE HOLES FROM 1" TO 1 1/4"  
DIAMETER & ONE OR TWO INCHES DEEP. THE CENTER OF THE HOLES  
ARE THE CORNER. ANGLE OF 90-45 ALONG THE NORTH LINE OF THE  
NE 1/4 OF SECTION 35 TO WEST LINE OF THE NE 1/4 OF SEC 36.
- 1854 WILSON SUBDIVISION "ROCKWELLS ADD" BK 2 PG 51. LIMESTONE  
WITH HOLE DRILLED IN CENTER, N89-18W 2561.34 TO SW COR SEC  
26 (VARIATION OF NEEDLE 6-25E). 33 EAST OF WEST ROW LINE OF  
SEVENTH ST., 33 SOUTH OF NORTH ROW LINE OF LIBERTY ST., &  
660 SOUTH OF CENTER OF MIDDLE ST.
- 1886 RUGER'S SUBDIVISION "WHEELER'S ADDITION TO BELOIT "BOOK 4  
PAGE 37B SHOWS THE SW CORNER OF SECTION 25 AND STATES THAT  
THE SOUTH 1/16TH CORNER OF THAT SW 1/4 IS A TRIANGULAR  
POINTED LIMESTONE 15X14X12. HE DOES NOT STATE THE DISTANCE  
TO THE SECTION CORNERS. HE SHOWS THE SECTION LINE AND  
NORTH/SOUTH DISTANCES TO VARIOUS POINTS ON THE MAP.
- 1889 HOLMES SUBDIVISION "HOPKINS ADDITION" BK 4 PG 48. CALLS FOR  
STONE MONUMENT, S4-16E 676.8' TO IRON BOLT IN CENTER OF  
MERRILL ST & BLUFF ST, CORNER IS 33 EAST OF WEST ROW LINE OF  
BLUFF ST, S85-10W 658.65 TO IRON PIPE AT THE CENTER OF  
LIBERTY ST & OAK ST, & BEARINGS ARE MAGNETIC COURSES WITH A  
VARIATION 4-17E.
- 1890 WILSON "ADAMS SUBDIVISION OF BLOCK 5" BK 5 PG 14. HE STATES  
THAT MERRILS ADDITION WAS STAKED WITH A CHAIN 6 INCHES TOO  
LONG. CALLS FOR A 33.25 RIGHT OF WAY ON BLUFF AND A 33.25  
RIGHT OF WAY ON LIBERTY AVE.
- 1891 HOLMES'S "PEET AND SALMON'S" SUBDIVISION BOOK 5 PG 15.  
STATES THAT THE POINT OF BEGINNING IS S1-15W 340.56 FROM THE  
SECTION CORNER. THE BEARING AND DISTANCE TO A COMPUTED  
POSITION IS S1-40-00W 339.35. HE ALSO STATES THE DISTANCE  
AND BEARING FROM A LOT CORNER ON THE SOUTH SIDE OF LAWTON  
FROM A STONE MONUMENT AT THE INTERSECTION OF LAWTON AVENUE  
AND THE NORTH LINE OF SECTION 36 IS S52-23W 196.35. THE  
DISTANCE FROM A FOUND PIPE TO THIS COMPUTED POSITION IS S56-  
55-38W 197.48.
- 1942 BATTERMAN. PLAT OF SURVEY OF THE FAIRBANKS MORSE COMPANY.  
HIS MAP WHICH WAS FILED IN THE BELOIT CITY ENGINEER'S  
OFFICE SHOWS THE SOUTH LINE OF THE SW 1/4 OF SECTION 25.  
HE SHOWS NORTH/SOUTH DISTANCES FROM THE SECTION LINE TO  
VARIOUS MONUMENTS. HIS MAP CALLS FOR A DISTANCE OF 2641.82  
FROM THE EAST QUARTER CORNER TO THE SOUTHWEST CORNER OF  
SECTION 26. HE ALSO CALLS FOR AN ANGLE OF 90-12-30 AT THE  
SOUTHWEST CORNER OF THE SECTION. I COMPUTED AN ANGLE OF 90-  
14-39. HIS MAP ALSO SHOWS THAT THE CORNER IS IN A  
BUILDING. THE COMPUTED DISTANCE FROM THE WEST QUARTER  
CORNER TO THE NW CORNER OF SECTION 25 IS 2631.29. BATTERMAN  
CALLS FOR A DISTANCE OF 2631.85. THE ANGLE NW CORNER-W 1/4  
CORNER-SW CORNER OF SECTION 25 IS 179-59-54. THIS ANGLE IS

*Donald Barnes*

*2/1/98*

*V-19*

TO THE RIGHT.

I DID NOT FIND THE CORNER. I DETERMINED THE POSITION OF THE CORNER FROM THE LOT CORNERS IN THE ADJACENT SUBDIVISION PLATS. THIS WAS ALSO IN HARMONY WITH THE CENTER OF THE N/S & E/W PAVEMENT. I DID NOT INSTALL A MONUMENT BECAUSE THE ROAD WILL BE REBUILT.

C) Was the corner restored through acceptance of (1) an obliterated evidence location, or, (2) a found perpetuated location?

ACCEPTED OBLITERATED EVIDENCE LOCATION.

D) Describe any material discrepancy between the location of the corner as restored or reestablished and the location of that corner as previously restored or reestablished by distance and direction. Show the discrepancy on the plan view drawing under (a), above. Show the distances between the corner as previously restored or reestablished and (1) the corner as restored or reestablished, and (2) to at least 4 of the witness monuments shown on the drawing in (a), above.

NONE

I, Donald Barnes, hereby certify that the corner points as identified by the corner code index were, in a field survey on, SEPTEMBER 11, 1997, established, re-established, monumented, re-monumented, recovered or restored as expressed below and in conformance with the regulations and rules as required in the current manual of survey instructions of the United States Department of Interior, Bureau of Land Management.

COUNTY SURVEYOR FILING DATA

seal

Date of computer entry \_\_\_\_\_

Date microfilmed \_\_\_\_\_

Number of included sheets \_\_\_\_\_  
CORNER CODE

*Donald Barnes*  
EMBOSS LAND SURVEYOR SEAL

2/A198

V-19

FLUEKIGER'S 1ST ADD  
BK 5 PG 12

ROCKWELL'S ADD  
BK 2 PG 51  
1854

DOW'S  
ADDITION  
BK 5 PG 9

NOGGLES ADD.  
BK 2 PG 5-6

N88-17-50E 2576.94  
REC N85-10E  
MAGNETIC COURSE  
VARIATION 4-17E  
REC N89-18W  
VARIATION OF NEEDLE  
8-25E

HOPKINS  
ADDITION  
BK 4 PG 48

ADAMS SUB  
OF BLOCK 5  
BK 5 PG 14  
1890

MERRILS  
ADDITION  
BK 2 PG 7


S 1/4 COR  
SEC 26

DID NOT PLACE MONUMENT.  
CORNER IS 0.16 SOUTH OF E/W  
CENTER OF PAVEMENT  
& 0.80' WEST OF N/S  
CENTER OF PAVEMENT.

OBSERVATION SHEETS #898 & 913

S89-42-44E 1084.77

N88-41-14E 1050.14

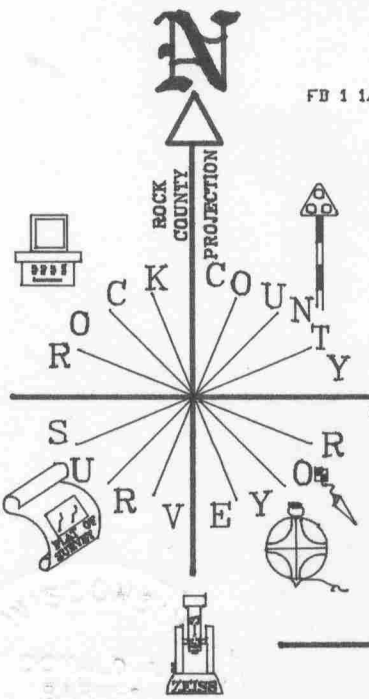

EMBOSSED SEAL  
*Donald Barnes*  
2/4/98

V-19