

PUBLIC LAND SURVEY MONUMENT RECORD

For Public Land Survey Corners in the


T. 1 N., R. 13 E.

CORNER CODE INDEX

	1	2	3	4	5	6	7	8	9	10	11	12	13	14	15	16	17	18	19	20	21	22	23	24	25
A																									
B	6	5	4	3	2																				
C																									
D	7	8	9	10	11	12																			
E																									
F																									
G	17	16	15	14	13																				
H																									
I	18	17	16	15	14	13																			
J																									
K																									
L	19	20	21	22	23	24																			
M																									
N																									
O	25	26	27	28	29	30																			
P																									
Q																									
R																									
S																									
T	31	32	33	34	35	36																			
U																									
V																									
W																									
X																									
Y																									

PLACE MONUMENT SYMBOL (◆) AT PROPER LOCATION ON ABOVE INDEX

EXAMPLE

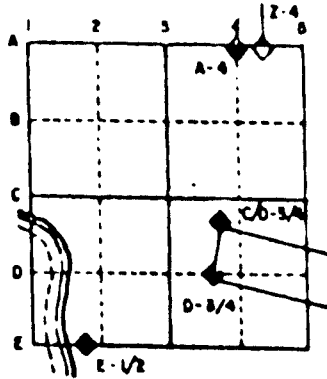

TURTLE TWP
ROCK COUNTY WI

IF AVAILABLE
STATE PLANE COORDINATES

North (Y) 206, 229, 85 Elev. (Z) _____
East (X) 506, 733, 76 Zone _____
Hor. Datum COUNTY Vert. Datum _____

◆ CORNER MONUMENT

○ WITNESS MONUMENT

Fd ALUM mon

Fd TIES IN VOL 5 PG 37

BEARINGS ARE BASED ON:

SHEET ___ OF ___

V9

CORNER CODE:

(B) Describe any record evidence, monument evidence, occupational evidence, testimonial evidence or any other material evidence you considered, and whether the monument was found or placed.

1836 LYONS SET POST CORNER TO SECTIONS 28&29,32&33 & MADE MOUND OF EARTH & SOD.

18?? VOL 6 PG 331 TOWNSHIP ROAD RECORDS. CENTER OF ROAD AT CORNER.

1973 LEE VOL 5 PG 37 SET ALUM. MON. & REFERENCED SAME. 1.5' NORTH OF CENTER OF PVMT.

FOUND ALUM. MON. & TIES.

C) Was the corner restored through acceptance of (1) an obliterated evidence location, or, (2) a found perpetuated location?

ACCEPTED FOUND MONUMENT.

D) Describe any material discrepancy between the location of the corner as restored or reestablished and the location of that corner as previously restored or reestablished by distance and direction. Show the discrepancy on the plan view drawing under (a), above. Show the distances between the corner as previously restored or reestablished and (1) the corner as restored or reestablished, and (2) to at least 4 of the witness monuments shown on the drawing in (a), above.

(E) Was the corner reestablished through lost corner proportionate methods? If so, show the method, including the directions and distances to other public land survey corners used as evidence or used for proportioning the corner location.

NO

I, Donald Barnes, hereby certify that the corner points as identified by the corner code index were, in a field survey on, 1994, established, re-established, monumented, re-monumented, recovered or restored as expressed below and in conformance with the regulations and rules as required in the current manual of survey instructions of the United States Department of Interior, Bureau of Land Management.

seal
Donald Barnes
7/12/95

COUNTY SURVEYOR FILING DATA

Date of computer entry _____

Date microfilmed _____

Number of included sheets _____

CORNER CODE

EMBOSS LAND SURVEYOR SEAL

A-E 7.08 REQUIREMENT