

# U.S. PUBLIC LAND SURVEY MONUMENT RECORD

For Public Land Survey Corners in:  
T. 1 N., R. 12 E

WI ADMINISTRATIVE CODE A-E 7.08 REQUIREMENT

## BELOIT TWP

CORNER CODE INDEX

ROCK COUNTY WI

IF AVAILABLE  
ROCK COUNTY COORDINATES PREFERRED

A	1	2	3	4	5	6	7	8	9	10	11	12	13	14	15	16	17	18	19	20	21	22	23	24	25
B	6																								
C																									
D																									
E																									
F	1																								
G																									
H																									
I																									
J																									
K	18																								
L																									
M																									
N																									
O																									
P	19																								
Q																									
R																									
S																									
T	30																								
U																									
V																									
W																									
X	31																								
Y																									
Z																									

North 203,851.07 Elev. \_\_\_\_\_

East 475,009.71

Hor. Datum COUNTY Vert. Datum \_\_\_\_\_

LATITUDE \_\_\_\_\_ ELLIPS. HT. \_\_\_\_\_

LONGITUDE \_\_\_\_\_

GPS (X) \_\_\_\_\_ TRAVERSE (X) \_\_\_\_\_

BASED ON THE FOLLOWING CONTROL:

PLACE MONUMENT SYMBOL  AT PROPER LOCATION ON ABOVE INDEX

CORNER MONUMENT

WITNESS MONUMENT

BEARINGS ARE BASED ON: \_\_\_\_\_

FIELD BOOK \_\_\_\_\_ PAGE # \_\_\_\_\_

SHEET 1 OF 2

SHOW A PLAN VIEW DRAWING DEPICTING THE CORNER MONUMENT AND SURROUNDING PHYSICAL FEATURES, INCLUDING THE EXCAVATION AREA AND DEPTH.

PLANNING & ZONING COMMITTEE ADOPTED THE ABOVE FORM ON 12/2/1982

CORNER CODE X-9

BE616

(B) Describe any record evidence, monument evidence, occupational evidence, testimonial evidence or any other material evidence you considered, and whether the monument was found or placed.

- 1834 HARRISON NORTH BETWEEN SECS 32 & 33  
2640 QUARTER SEC COR. ON GROUND DESCENDING TO THE SOUTH. SET POST  
& RAISED MOUND  
5148 RANDOM STATE LINE  
5280 COR TO SECS 28,29,32,&33 ON GROUND QUIETLY DESCENDING TO THE  
S.W. TO A RAVEN LEADING SOUTH. SET POST & RAISED MOUND.
- 1937 SUNNY VOL 3 PG 326 2666.2 TO CENTER OF SEC 33 & 2636.8 TO NW COR  
SEC 33.
- 1938 SUNNY VOL 3 PG 401 FD 1" PIPE IN GRAVEL RD. RESET WITH 1 1/2"  
CAPPED PIPE FLUSH WITH BLACK TOP RD. REFERENCED SAME.
- 1969 BATTERMAN VOL 4 PG 461 FD 1 1/2 CAPPED PIPE. REFERENCED SAME.  
SHOWS ON EAST R/W LINE OF RUBLE ROAD.
- 1975 SPRAGUE MAP #6044 2645.65 TO NE COR & 2658.46 TO SE COR SEC 31.
- 1983 BARNES VOL 6 PG 306 FD CAP PIPE 2654.03 TO CENTER 32, 2665.99 TO  
CENTER 33, 2655.64 TO SW COR SEC 33, 88-53-27 AT W 1/4 COR SEC 33  
FROM CENTER 33 TO SW COR SEC 33, & ANGLE OF 91-17-59 AT E 1/4 COR  
SEC 32 FROM SE COR SEC 32 TO CENTER SEC 32.
- 1989 KREBS MAP #12157 2637.56 TO NE COR SEC 32

FOUND CAPPED PIPE.

C) Was the corner restored through acceptance of (1) an obliterated evidence location, or, (2) a found perpetuated location?  
ACCEPTED FOUND PERPETUATED LOCATION.

D) Describe any material discrepancy between the location of the corner as restored or reestablished and the location of that corner as previously restored or reestablished by distance and direction. Show the discrepancy on the plan view drawing under (a), above. Show the distances between the corner as previously restored or reestablished and (1) the corner as restored or reestablished, and (2) to at least 4 of the witness monuments shown on the drawing in (a), above.  
NO

(E) Was the corner reestablished through lost corner proportionate methods? If so, show the method, including the directions and distances to other public land survey corners used as evidence or used for proportioning the corner location.  
NO

I, Donald Barnes, hereby certify that the corner points as identified by the corner code index were, in a field survey on, established, re-established, monumented, re-monumented, recovered or restored as expressed below and in conformance with the regulations and rules as required in the current manual of survey instructions of the United States Department of Interior, Bureau of Land Management.

seal

*Donald Barnes*  
*OCT 19, 1998*

EMBOSS LAND SURVEYOR SEAL

COUNTY SURVEYOR FILING DATA

Date of computer entry \_\_\_\_\_

Date microfilmed \_\_\_\_\_


Number of included sheets \_\_\_\_\_

CORNER CODE

A-E 7.08 REQUIREMENT

X-9

Donald Barnes  
 OCT 16, 1998

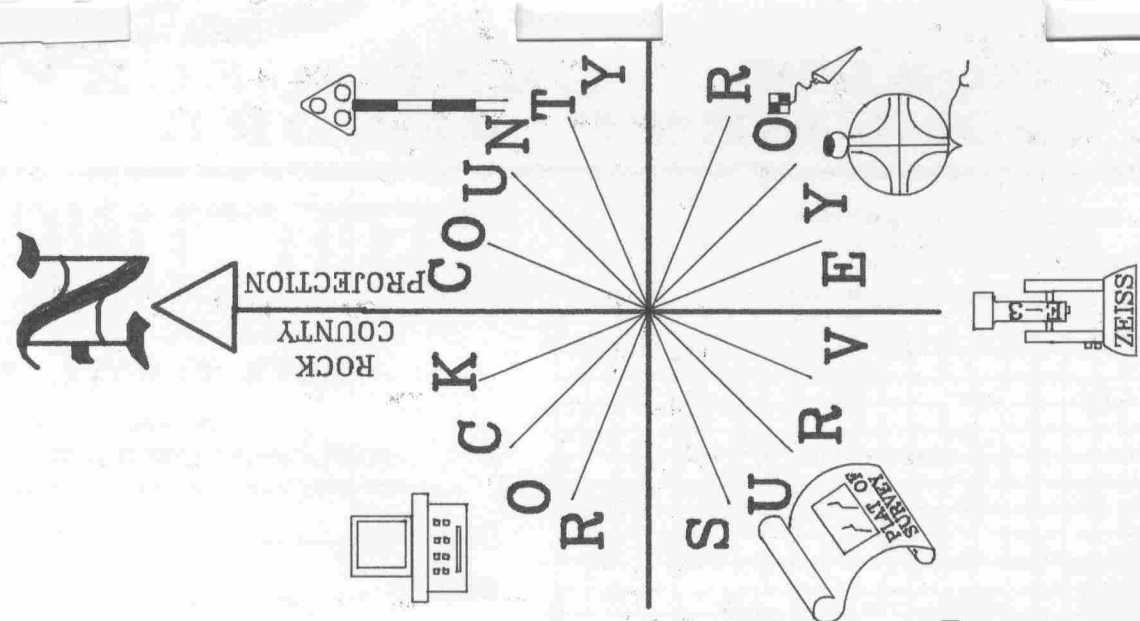

NE COR  
 SEC 32  
 COR AS REFERENCED

N0-17-24W 2637.65

S44-59-29E 3789.28

N45-35-09W 3696.31

S89-52-06E  
 39.80

S88-54-12E 2654.11

FD BENT PIPE  
 CENTER  
 SEC. 33

S89-05-33E 2666.00

E 1/4 COR  
 SEC 32

ST. LAWRENCE ST

FD REROD  
 CENTER  
 SEC. 32

N0-11-57W 2655.59

S44-32-09E 3796.74

N45-28-06E 3726.43

FD 1 1/2" CAPPED GAS  
 PIPE; 2' NORTH CENTER  
 PVMT. ON LINE N/S  
 FENCE; @ EAST N/S ROAD  
 R/W LINE.

STA #193 R/R  
 5' WEST OF WEST EDGE  
 PVMT EXTENDED FROM NORTH,  
 1' NORTH OF CENTER OF  
 PVMT.

SE COR  
 SEC 32  
 POLY. MON.

X-9