
## U.S.

## PUBLIC LAND SURVEY MONUMENT RECORD

For Public Land Survey Corners in: T. N., R. 7 E

CORNER CODE INDEX

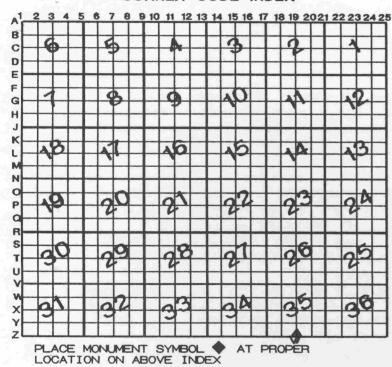

WI ADMINISTRATIVE CODE A-E 7.08 REQUIREMENT

TWP

## ROCK COUNTY WI

IF AVAILABLE
ROCK COUNTY COORDINATES PERFERRED

North \_\_\_\_\_ Elev. \_\_\_\_

East \_\_\_\_\_

Hor. Datum \_\_\_\_ Vert. Datum \_\_\_\_

LATITUDE \_\_\_\_ ELLIPS. HT

LONGITUTE \_\_\_\_\_

GPS (X) \_\_\_ TRAVERSE (X) \_\_\_

BASED ON THE FOLLOWING CONTROL:

◆CORNER MONUMENT

O WITNESS MONUMENT

ARINGS ARE BASED ON:

(a)

FIELD BOOK \_\_\_\_\_PAGE # \_\_\_\_\_ OF SHOW A PLAN VIEW DRAWING DEPICTING THE CORNER MONUMENT AND SURROUNDING PHYSICAL FEATURES, INCLUDING THE EXCAVATION AREA AND DEPTH.
PLANNING & ZONING COMMITTEE ADOPTED THE ABOVE FORM ON 12/2/1962

CORNER CODE 2-19

BE630

(B) Describe any record evidence, monument evidence, occupational evidence, testimonial evidence or any other material evidence you considered, and whether the monument was found or placed. 1833 LYONS BASE LINE (N.W TERR) EAST ALONG THE SOUTH SIDE OF SEC 35.

VAR 6-00E.

TO A WHITE ASH 6 INCHES DIAMETER ON THE RIGHT ON WEST 2405.7' BANK OF ROCK RIVER, FRACTIONAL CORNER TO SEC 35- A RED CEDAR STANDS NEAR BY ON THE UP STREAM SIDE OF SAID ASH, AND THREE OTHERS STAND NEAR BY BELOW.

1/4 SEC. CORNER IN THE RIVER, WHICH RUNS SOUTH.

2640 TO A LARGE HEWN POST ON THE LEFT BANK OF RIVER. BUR OAK 2758.14

20 N6E 20, ELM 18 S12W 18.

SET POST IN A PIECE OF BOTTOM PRAIRIE FOR CORNER TO 5280 SECTIONS 35 & 36. BUR OAK 20 N25W 364, BLACK OAK 12 N21E 387. WEST SIDE OF RIVER 2ND RATE PRAIRIE, EAST SIDE TIMBERED BOTTOM LAND 1ST RATE.

1834 HARRISON (LYON'S BROTHER IN LAW) MAP SHOWS THE RANDOM STATE LINE IN SOUTH PART OF SECTION 26.

1854 MASSER - HACKETT SUB BK 1 PG 4. SHOWS IN RIVER JUST WEST OF EAST BANK. N/S CENTER OF SEC 35 IS N0-35E.

DID NOT SEARCH NOR ESTABLISH CORNER.

- C) Was the corner restored through acceptance of (1) an obliterated evidence location, or, (2) a found perpetuated location?
- D) Describe any material discrepancy between the location of the corner as restored or reestablished and the location of that corner as previously restored or reestablished by distance and direction. Show the discrepancy on the plan view drawing under (a), above. Show the distances between the corner as previously restored or reestablished and (1) the corner as restored or reestablished, and (2) to at least 4 of the witness monuments shown on the drawing in (a), above.
- (E) Was the corner reestablished through lost corner proportionate If so, show the method, including the directions and distances to other public land survey corners used as evidence or used for proportioning the corner location. NEEDS TO BE. THIS REQUIRES THE ACTION OF BOTH STATES AND CONGRESS OR THE FEDERAL SUPREME COURT.
- I, Donald Barnes, hereby certify that the corner points as identified by the corner code index were, in a field survey on, established, reestablished, monumented, re-monumented, recovered or restored as expressed below and in conformance with the regulations and rules as required in the current manual of survey instructions of the United States Department of Interior, Bureau of Land Management.

EMBOSS LAND SURVEYOR SEAL

COUNTY SURVEYOR FILING DATA

Date of computer entry\_

Date microfilmed \_

Number of included sheets CORNER CODE

A-E 7.08 REQUIREMENT