

# U.S. PUBLIC LAND SURVEY MONUMENT RECORD

For Public Land Survey Corners in the


T. 1 N., R. 12 E.

## CORNER CODE INDEX

	1	2	3	4	5	6	7	8	9	10	11	12	13	14	15	16	17	18	19	20	21	22	23	24	25
A																									
B																									
C	6																								
D		5																							
E			4																						
F				3																					
G					2																				
H																									
I	7																								
J		8																							
K			9																						
L				10																					
M					11																				
N						12																			
O							13																		
P								14																	
Q									15																
R										16															
S											17														
T												18													
U													19												
V														20											
W															21										
X																22									
Y																	23								
Z																		24							
																			25						
																				26					
																					27				
																						28			
																							29		
																								30	
																									31
																									32
																									33
																									34
																									35
																									36

PLACE MONUMENT SYMBOL (◆) AT PROPER LOCATION ON ABOVE INDEX

### EXAMPLE

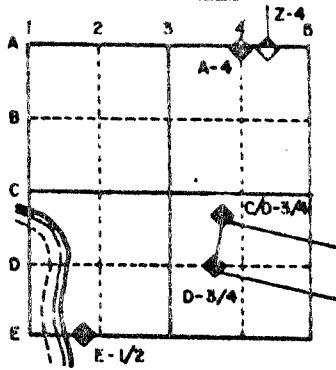

BELOIT TWP  
ROCK COUNTY WI

IF AVAILABLE  
STATE PLANE COORDINATES

North (Y) \_\_\_\_\_ Eleve. (Z) \_\_\_\_\_  
 East (X) \_\_\_\_\_ Zone \_\_\_\_\_  
 Hor. Datum \_\_\_\_\_ Vert. Datum \_\_\_\_\_

◆ CORNER MONUMENT

○ WITNESS MONUMENT

SEE OTHER SIDE


BEARINGS ARE BASED ON:

SHEET \_\_\_\_\_ OF \_\_\_\_\_

CORNER CODE A 19

**MICROFILMED**


COUNTY <i>Rock</i>		
TOWN <i>of Beloit</i>		
HIGHWAY <i>Townline Road</i>		
SECTION <i>2</i>	TOWNSHIP <i>1 N</i>	RANGE <i>12 E</i>
TYPE OF LANDMARKS <i>Witness</i> ① <i>Brass Cap Conc Monuments (Type "A")</i>		

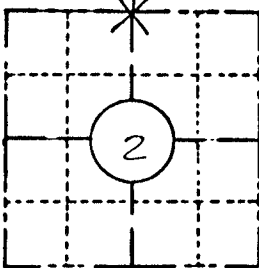

**LOCATION SKETCH**  
 (Location of landmark indicated by "x")



This space for copy of field notes or ties to the above described landmarks

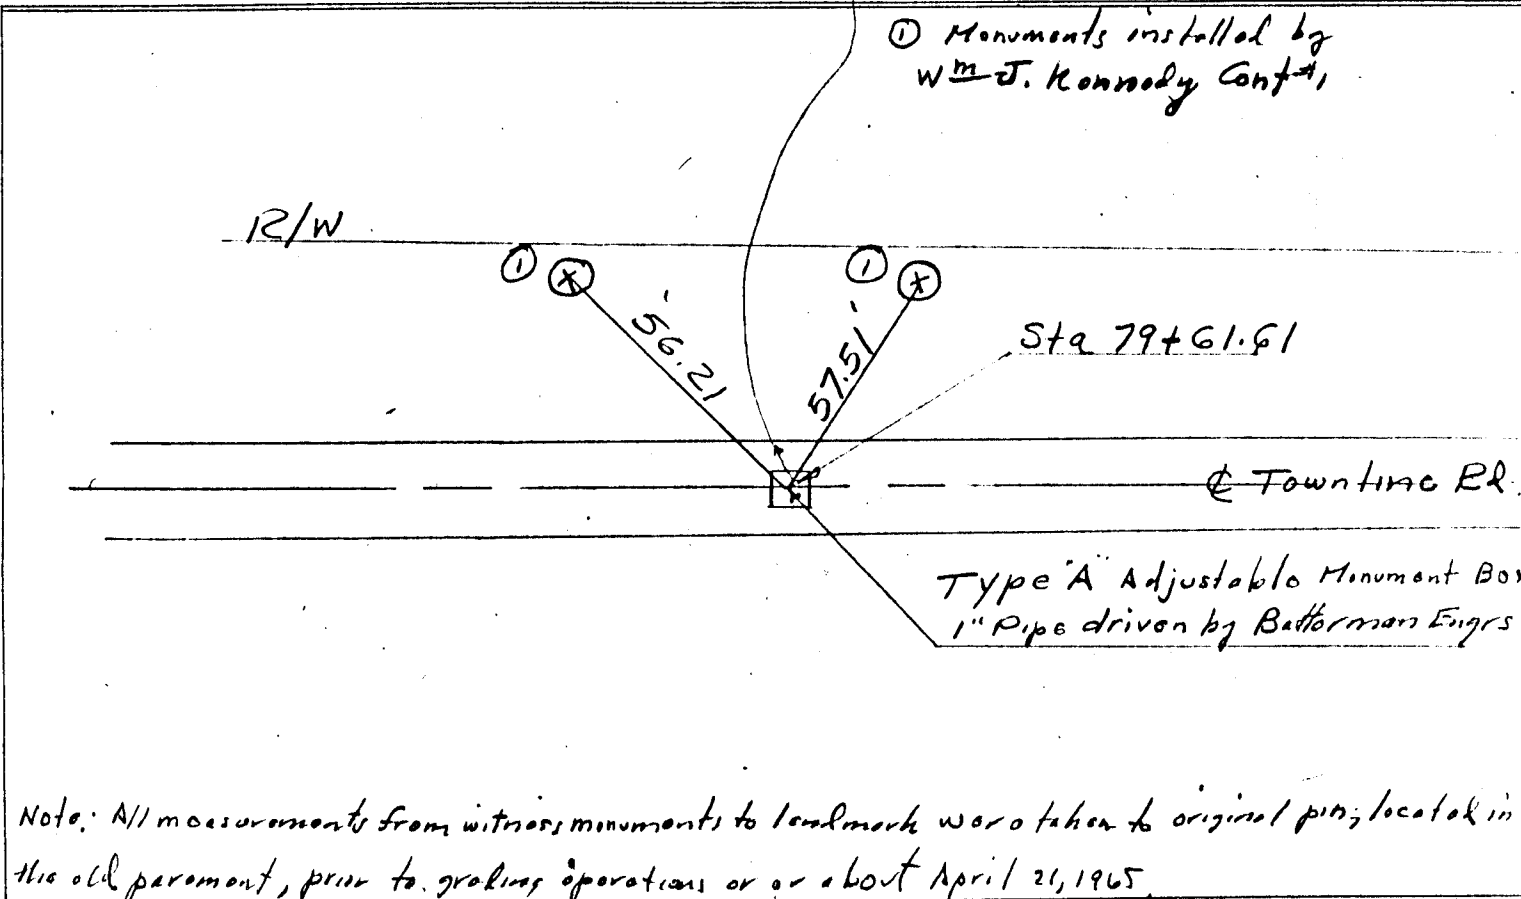

Note: All measurements from witness monuments to landmark were taken to original pin; located in the old pavement, prior to grading operations or or about April 21, 1965.

FILED UNDER PROJECT NUMBER <i>50626 (5)</i>			COUNTY CLERK'S OFFICE		
SHC DISTRICT OFFICE NUMBER <i>DNE</i>			CITY <i>MADISON</i>	COUNTY <i>DANE</i>	WISCONSIN } S:
LOCATED OR ESTABLISHED BY NAME <i>O.I. Koski</i>			DATE RECEIVED FOR RECORD	DATE COPY SENT TO COUNTY SURVEYOR <i>12/20/65</i>	
TITLE <i>P. Eng</i>			SIGNATURE OF COUNTY CLERK		