

## U.S. PUBLIC LAND SURVEY MONUMENT RECORD

For Public Land Survey Corners in the T. / N., R. / 2E.

CORNER CODE INDEX

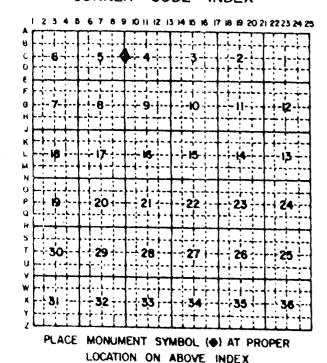

€.)

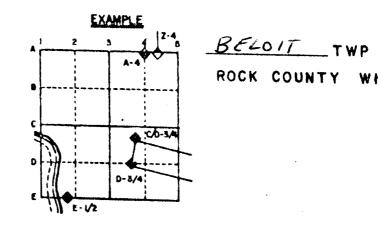


IF AVAILABLE
STATE PLANE COURDINATES
North (Y) 230 203 03 03

Hor. Datum COUNTY Vert. Datum \_

CORNER MONUMENT

O WITNESS MONUMENT

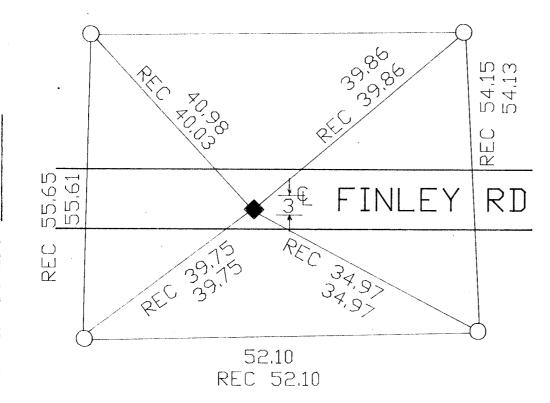

FIELD BOOK #3 (ROCK) PG 41

- O FOUND 1" PIPE
- FOUND TOP OF MONUMENT BOX
  .3' DEEP, PLACED PK FROM
  TIES, PLACED PK 1.00 TO THE
  NE AND NW.

SHEET OF

CORNER CODE: C9

- (B) Describe any record evidence, monument evidence, occupational evidence, testimonial evidence or any other material evidence you considered, and whether the monument was found or placed.
- 1851 McVEAN VOL 1 PG 1 USED CORNER TO SUBDIVIDE SECTION 4, BUT STATES NOTHING ABOUT THE CORNER. SHOWS 2617.56 TO THE SW,2909.94' TO THE NW, AND 5266.80' TO THE E 1/4 CORNER OF SECTION 4.
- 1962 BATTERMAN JR. VOL 4 PG 177 FOUND OLD AXLE. REFERENCED AND PLACED MONUMENT BOX.
- 1970 LEE VOL 6 PG 108 CALLS FOR 2653.68 TO THE SW CORNER OF SECTION 4.
- 1977 LEE VOL 6 PG 108 CALLS FOR 2690.59 TO THE CENTER AND 2916.68 TO THE NW CORNER OF SECTION 4.
- 1980 BARNES VOL 6 PG 108 CALLS FOR 2616.07 TO THE SW CORNER OF SECTION 4.

FOUND TOP OF MONUMENT BOX 0.3' DEEP. PLACED PK FROM TIES.

- C) Was the corner restored through acceptance of (1) an obliterated evidence location, or, (2) a found perpetuated location?

  ACCEPTED FOUND PERPETUATED LOCATION.
- D) Describe any material discrepancy between the location of the corner as restored or reestablished and the location of that corner as previously restored or reestablished by distance and direction. Show the discrepancy on the plan view drawing under (a), above. Show the distances between the corner as previously restored or reestablished and (1) the corner as restored or reestablished, and (2) to at least 4 of the witness monuments shown on the drawing in (a), above.
- (E) Was the corner reestablished through lost corner proportionate methods? If so, show the method, including the directions and distances to other public land survey corners used as evidence or used for proportioning the corner location.
- I, Donald Barnes, hereby certify that the corner points as identified by the corner code index were, in a field survey on, November 29,1990, established, re-established, monumented, remonumented, recovered or restored as expressed below and in conformance with the regulations and rules as required in the current manual of survey instructions of the United States Department of Interior, Bureau of Land Management.

COUNTY SURVEYOR FILING DATA

Date of computer entry\_\_\_\_\_

Date microfilmed \_\_\_\_\_

Number of included sheets \_\_\_\_\_

CORNER CODE

AFFIX YOUR LAND SURVEYOR SEAL

Dall Barnes

0 9