

U.S. PUBLIC LAND SURVEY MONUMENT RECORD

For Public Land Survey Corners in:

WI ADMINISTRATIVE CODE A-E 7.08 REQUIREMENT

T. 1N., R. 12E 4th P.M.

CORNER CODE INDEX

A	1	2	3	4	5	6	7	8	9	10	11	12	13	14	15	16	17	18	19	20	21	22	23	24	25
B	6																								
C																									
D																									
E																									
F																									
G	7	8	9	10	11	12																			
H																									
I																									
J																									
K	18	17	16	15	14	13																			
L																									
M																									
N																									
O	19	20	21	22	23	24																			
P																									
Q																									
R																									
S	30	29	28	27	26	25																			
T																									
U																									
V																									
W	31	32	33	34	35	36																			
X																									
Y																									
Z																									

BELOIT TWP
ROCK COUNTY, WI

IF AVAILABLE
ROCK COUNTY COORDINATES PREFERRED

North 227,758.55 Elev. _____

East 475,100.47

Hor. Datum _____ Vert. Datum _____

LATITUDE _____ ELLIPS. HT. _____

LONGITUDE _____

ELLIPS. DATUM _____
NAD83(91) _____ COUNTY _____ LIST _____

GPS (X) _____ TRAVERSE (X) _____


BASED ON THE FOLLOWING CONTROL:

PLACE MONUMENT SYMBOL  AT PROPER LOCATION ON ABOVE INDEX

 CORNER MONUMENT

WITNESS MONUMENT

(a)

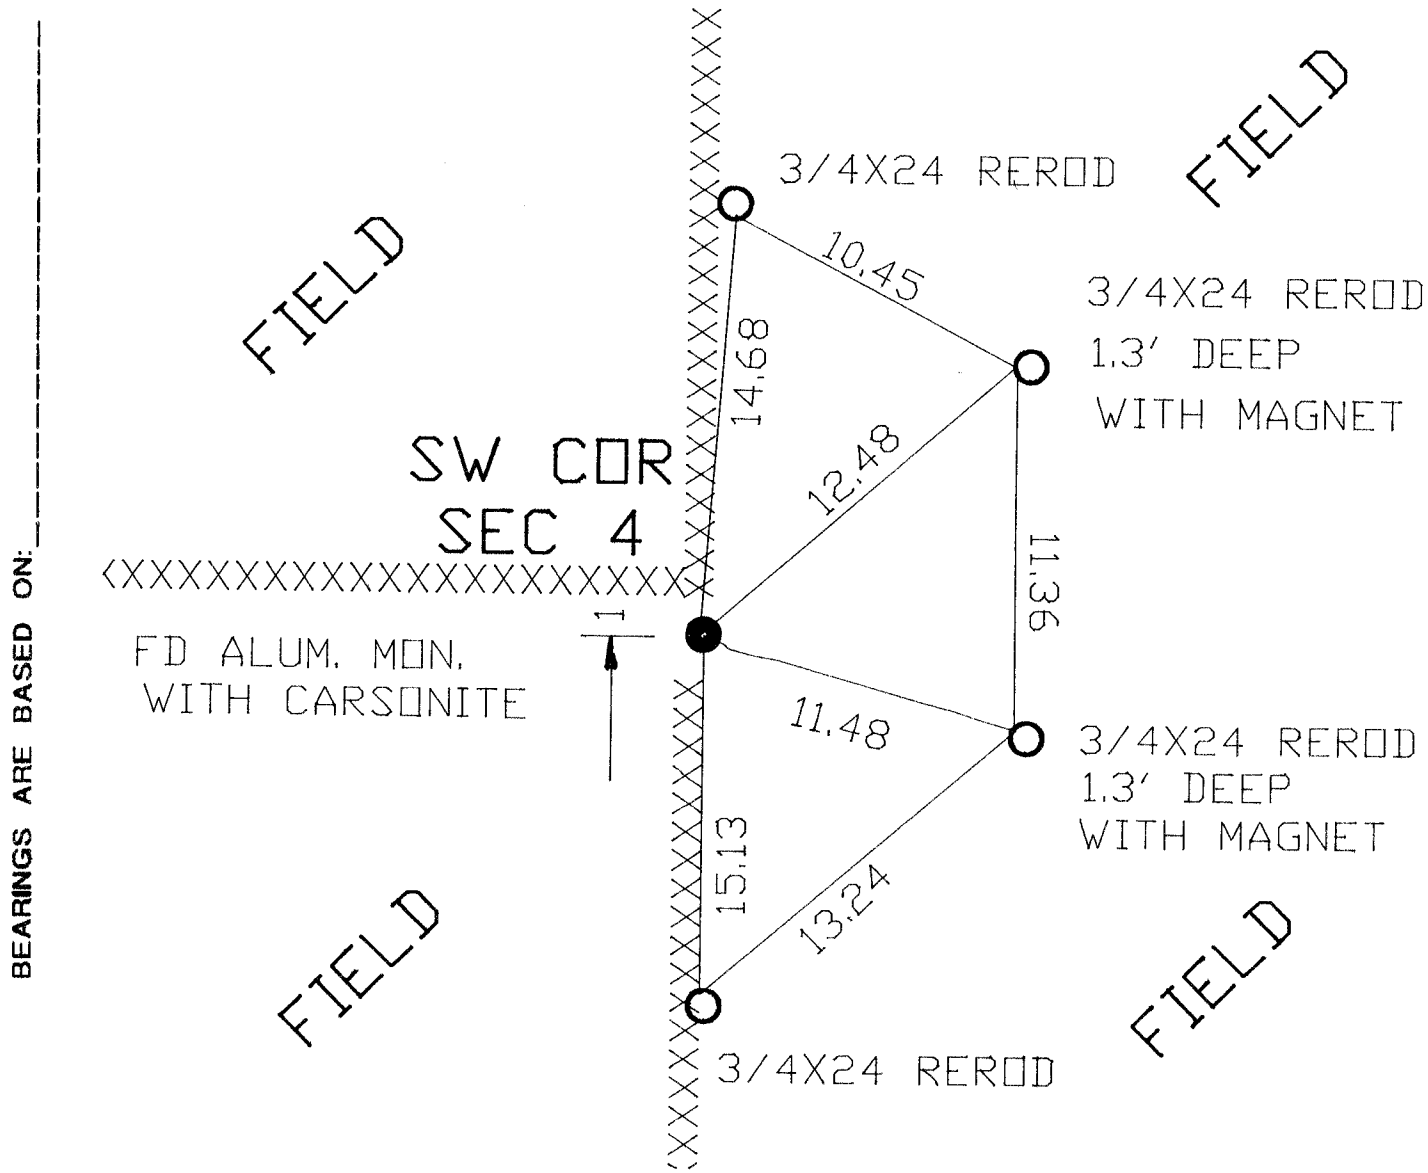

OBSERVATION sheet

FIELD BOOK _____ PAGE # _____

SHEET _____ OF _____

SHOW A PLAN VIEW DRAWING DEPICTING THE CORNER MONUMENT AND SURROUNDING PHYSICAL FEATURES, INCLUDING THE EXCAVATION AREA AND DEPTH.

PLANNING & ZONING COMMITTEE ADOPTED THE ABOVE FORM ON 12/2/1982

CORNER CODE E-9

BE 525

(B) Describe any record evidence, monument evidence, occupational evidence, testimonial evidence or any other material evidence you considered, and whether the monument was found or placed.

- 1851 Mc VEAN VOL 1 PG 1 2677.62 TO S 1/4 COR SEC 4 & 2617.56 TO W 1/4 COR SEC 4
- 1970 LEE VOL 6 PG 108 2653.68 TO W 1/4 COR SEC 4 & 2605.58 TO W 1/4 COR SEC 9.
- 1980 BARNES VOL 6 PG 108 2684.20 TO S 1/4 COR SEC 5, 2677.2 TO S 1/4 COR SEC 4, 2644.02 TO W 1/4 COR SEC 9, 2616.07 TO W 1/4 COR SEC 4, ANGLE 90-36-46 AT SE COR SEC 5 FROM E 1/4 COR SEC 8 TO S 1/4 COR SEC 5, & ANGLE 89-59 AT SE COR SEC 5 FROM W 1/4 COR SEC 4 TO S 1/4 COR SEC 4.
- 1980 BARNES VOL 6 PG 111 DUG & FOUND A STAKE SURROUNDED BY 4 HH 1.3' DEEP. REPLACED WITH ALUM. MON. 1' SOUTH OF E/W FENCE ON LINE WITH N/S FENCE.

SEARCHED FOR A MONUMENT AT LOCATION DETERMINED BY LEE'S DISTANCES. POSITION IS IN FARM FIELD. FOUND NOTHING.

C) Was the corner restored through acceptance of (1) an obliterated evidence location, or, (2) a found perpetuated location?
ACCEPTED FOUND ALUM. MON.

D) Describe any material discrepancy between the location of the corner as restored or reestablished and the location of that corner as previously restored or reestablished by distance and direction. Show the discrepancy on the plan view drawing under (a), above. Show the distances between the corner as previously restored or reestablished and (1) the corner as restored or reestablished, and (2) to at least 4 of the witness monuments shown on the drawing in (a), above.
LEE'S RECORD DISTANCES AND ANGLES INDICATE THAT HE ESTABLISHED THE CORNER ABOUT S41-18E 51.6' OF THE ALUM. MON.

(E) Was the corner reestablished through lost corner proportionate methods? If so, show the method, including the directions and distances to other public land survey corners used as evidence or used for proportioning the corner location.
NO

I, Donald Barnes, hereby certify that the corner points as identified by the corner code index were, in a field survey on, MAY 1998, established, re-established, monumented, re-monumented, recovered or restored as expressed below and in conformance with the regulations and rules as required in the current manual of survey instructions of the United States Department of Interior, Bureau of Land Management.

Donald Barnes
6/17/98

COUNTY SURVEYOR FILING DATA

Date of computer entry _____

Date microfilmed _____

Number of included sheets _____

CORNER CODE

EMBOSS LAND SURVEYOR SEAL

A-E 7.08 REQUIREMENT

E-9