

# U.S. PUBLIC LAND SURVEY MONUMENT RECORD

For Public Land Survey Corners in:

WI ADMINISTRATIVE CODE A-E 7.08 REQUIREMENT

T. 1N., R. 12E 4th P.M.

## BELOIT TWP TWP

CORNER CODE INDEX

### ROCK COUNTY, WI

IF AVAILABLE  
ROCK COUNTY COORDINATES PREFERRED

A	1	2	3	4	5	6	7	8	9	10	11	12	13	14	15	16	17	18	19	20	21	22	23	24	25
B	6																								
C																									
D																									
E																									
F																									
G	7	8	9																						
H																									
I																									
J																									
K																									
L	18	17	16																						
M																									
N																									
O																									
P	19	20	21	22	23	24																			
Q																									
R																									
S	30	29	28	27	26	25																			
T																									
U																									
V																									
W																									
X																									
Y																									
Z																									

North 222,323.38 Elev. \_\_\_\_\_

East 483,018.05

Hor. Datum COUNTY Vert. Datum \_\_\_\_\_

LATITUDE \_\_\_\_\_ ELLIPS. HT. \_\_\_\_\_

LONGITUDE \_\_\_\_\_

ELLIPS. DATUM  
NAD83(91) \_\_\_\_\_ COUNTY \_\_\_\_\_ LIST \_\_\_\_\_

GPS (X) \_\_\_\_\_ TRAVERSE (X) \_\_\_\_\_

BASED ON THE FOLLOWING CONTROL:

PLACE MONUMENT SYMBOL  AT PROPER LOCATION ON ABOVE INDEX

 CORNER MONUMENT

WITNESS MONUMENT

(a)

BEARINGS ARE BASED ON:

FIELD BOOK \_\_\_\_\_ PAGE # \_\_\_\_\_

SHEET 1 OF 2

SHOW A PLAN VIEW DRAWING DEPICTING THE CORNER MONUMENT AND SURROUNDING PHYSICAL FEATURES, INCLUDING THE EXCAVATION AREA AND DEPTH.

PLANNING & ZONING COMMITTEE ADOPTED THE ABOVE FORM ON 12/2/1982

CORNER CODE 515

BE548

(B) Describe any record evidence, monument evidence, occupational evidence, testimonial evidence or any other material evidence you considered, and whether the monument was found or placed.

- 1834 HARRISON EAST ON RANDOM BETWEEN SEC 10 & 15
  - 2640 TEMPY 1/4 SEC COR.
  - 3462.36 LEAVE PRAIRIE & ENTER THICKET
  - 4818 LEAVE THICKET & ENTER TIMBER
  - 5244.36 INT. EAST BOUNDARY 20.46' NORTH OF POST COR. WEST
    - SET POST & RAISED MOUND ON SMALL POINT CRS S.W.
    - 5244.36 SEC COR.
- 1851 McVEAN VOL 4 PG 291 5349.96 TO N 1/4 COR SEC 10.
- 1874 RUGER VOL 2 PG 143 FD OLD STAKE . DROVE NEW STAKE & PUT ON TOP OF IT HH STONE. THE HH IS RED.
- 1966 BATTERMAN VOL 4 PG 291 FD 3/4" PIN 33.11 W OF MON & ON SEC LINE. 2629.00 TO NW COR SEC 15, 2600.34 TO NE COR SEC 15, FD 3/4 IRON PIN WHICH SHIMEALL SET OVER LS & OLD POST SURROUNDED BY HH IN LINE WITH OLD FENCE RIDGE TO NORTH. REPLACED PIN WITH CONC. MON LOCATION OF MON. VERIFIED BY PRORATION OF OCCUPATION FENCES TO THE WEST & PRODUCING TO THE NORTH, THE FENCE LINE WHICH EXTENDS FROM THE CENTER OF SEC 15 TO THE S 1/4 OF SEC 15. SET YELLOW POST 1.5 NE OF MON.

FOUND BRASS DISK IN CONCRETE MONUMENT.

C) Was the corner restored through acceptance of (1) an obliterated evidence location, or, (2) a found perpetuated location?  
ACCEPTED FOUND PERPETUATED LOCATION.

D) Describe any material discrepancy between the location of the corner as restored or reestablished and the location of that corner as previously restored or reestablished by distance and direction. Show the discrepancy on the plan view drawing under (a), above. Show the distances between the corner as previously restored or reestablished and (1) the corner as restored or reestablished, and (2) to at least 4 of the witness monuments shown on the drawing in (a), above.

(E) Was the corner reestablished through lost corner proportionate methods? If so, show the method, including the directions and distances to other public land survey corners used as evidence or used for proportioning the corner location.  
NO

I, Donald Barnes, hereby certify that the corner points as identified by the corner code index were, in a field survey on, established, re-established, monumented, re-monumented, recovered or restored as expressed below and in conformance with the regulations and rules as required in the current manual of survey instructions of the United States Department of Interior, Bureau of Land Management.

*Donald Barnes*  
Seal  
*Oct 9, 1998*

COUNTY SURVEYOR FILING DATA

Date of computer entry \_\_\_\_\_

Date microfilmed \_\_\_\_\_



Number of included sheets \_\_\_\_\_

CORNER CODE

*5-15*

EMBOSS LAND SURVEYOR SEAL

A-E 7.08 REQUIREMENT

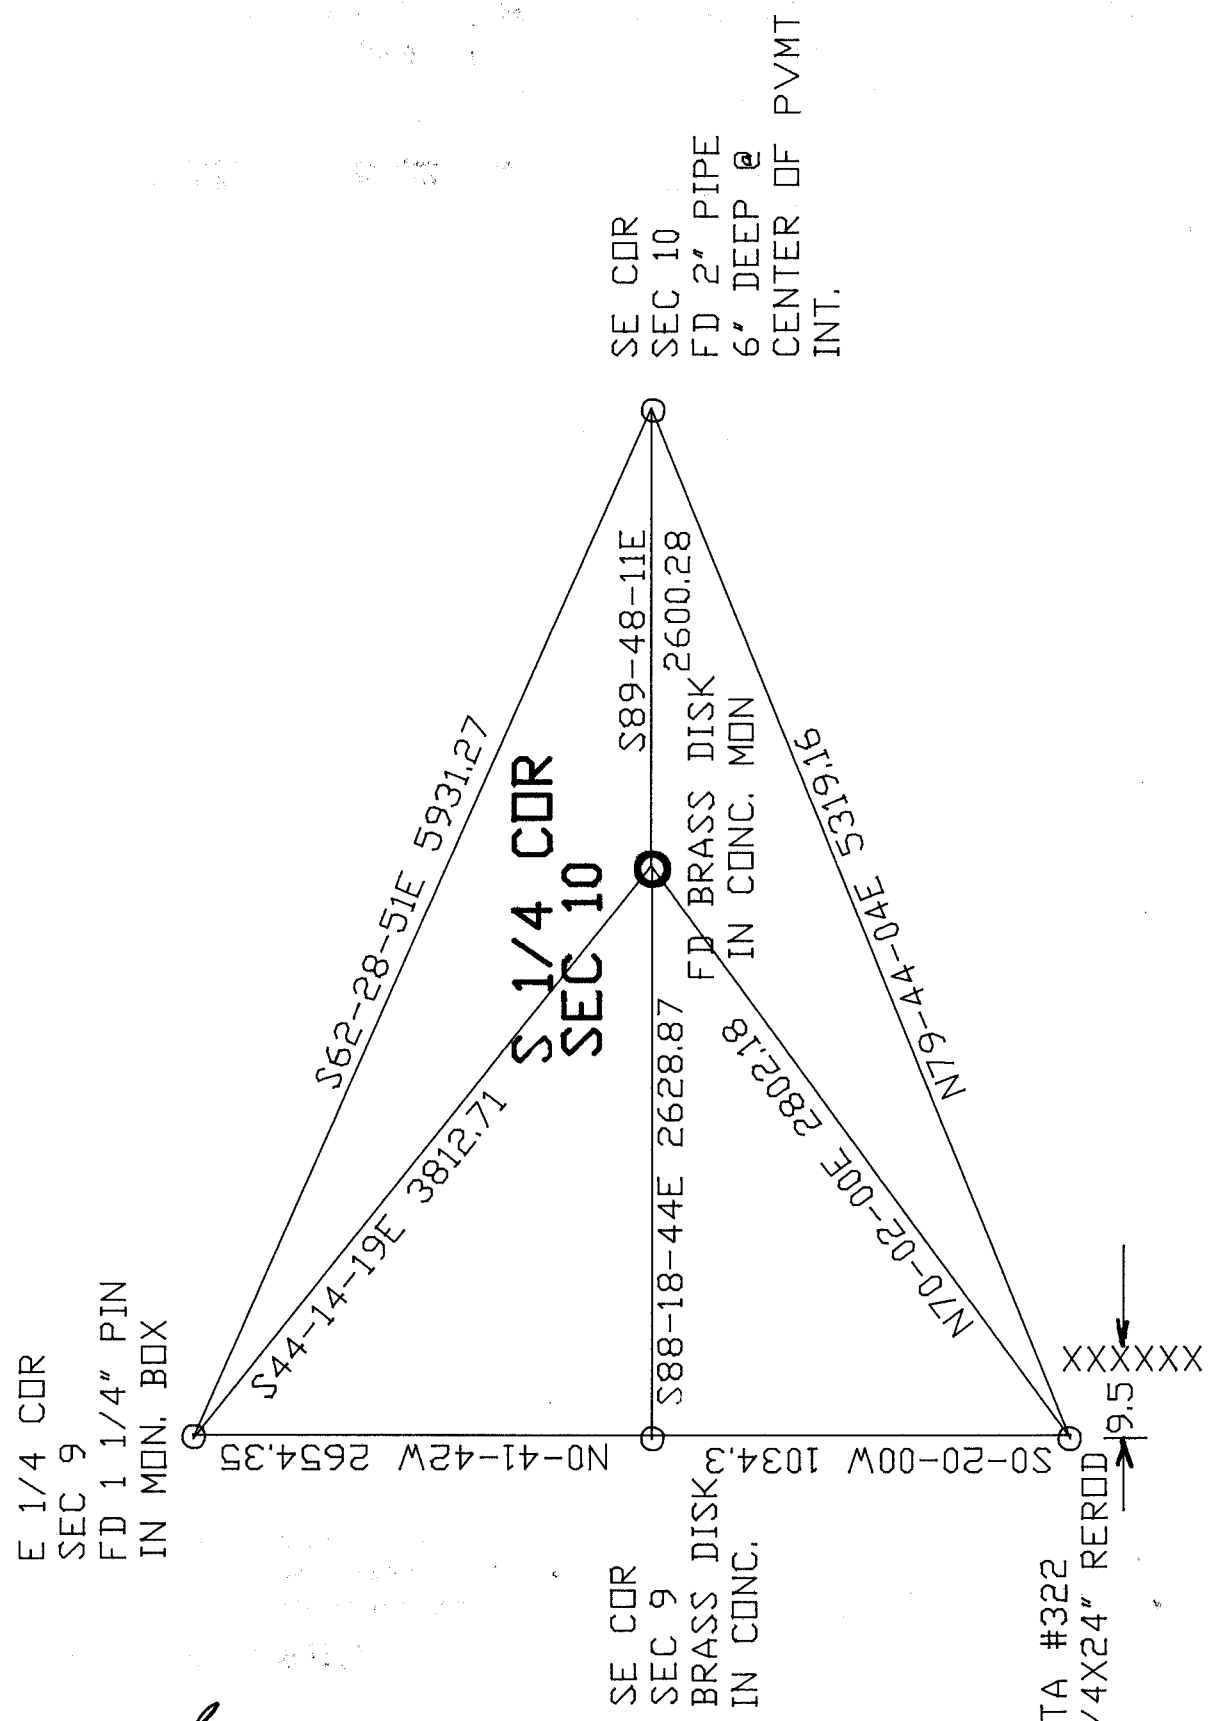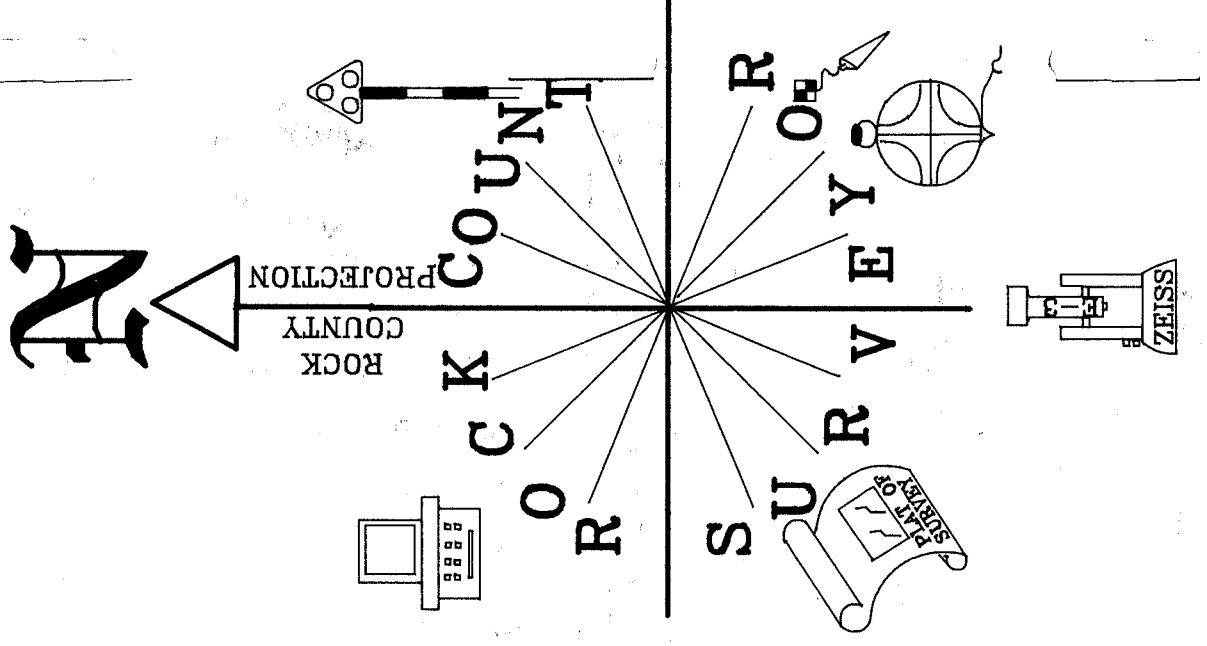

*Donald Barnes  
Oct 9, 1998*

**J-15**