

U.S. PUBLIC LAND SURVEY MONUMENT RECORD

For Public Land Survey Corners in:

WI ADMINISTRATIVE CODE A-E 7.08 REQUIREMENT

T. 1N., R. 12E 4th P.M.

CORNER CODE INDEX

BELOIT TWP

TWP
ROCK COUNTY, WI

IF AVAILABLE
ROCK COUNTY COORDINATES PREFERRED

A	1	2	3	4	5	6	7	8	9	10	11	12	13	14	15	16	17	18	19	20	21	22	23	24	25
B	6				5				4					3					2					1	
C																									
D																									
E																									
F	7				8				9					10					11					12	
G																									
H																									
I																									
J																									
K	18				17				16					15					14					13	
L																									
M																									
N																									
O	19				20				21					22					23					24	
P																									
Q																									
R																									
S	30				29				28					27					26					25	
T																									
U																									
V																									
W																									
X	31				32				33					34					35					36	
Y																									
Z																									

North 217,209.30 Elev. _____

East 469,681.89

Hor. Datum Country Vert. Datum _____

LATITUDE _____ ELLIPS. HT. _____

LONGITUDE _____

ELLIPS. DATUM
NAD83(91) _____ COUNTY _____ LIST _____

GPS (X) _____ TRAVERSE (X) _____

BASED ON THE FOLLOWING CONTROL:

PLACE MONUMENT SYMBOL AT PROPER LOCATION ON ABOVE INDEX

CORNER MONUMENT

WITNESS MONUMENT

BEARINGS ARE BASED ON:

FIELD BOOK _____ PAGE # _____

SHEET 1 OF 1

SHOW A PLAN VIEW DRAWING DEPICTING THE CORNER MONUMENT AND SURROUNDING PHYSICAL FEATURES, INCLUDING THE EXCAVATION AREA AND DEPTH.

PLANNING & ZONING COMMITTEE ADOPTED THE ABOVE FORM ON 12/2/1982

CORNER CODE N-5

BE563

(B) Describe any record evidence, monument evidence, occupational evidence, testimonial evidence or any other material evidence you considered, and whether the monument was found or placed.

1834 HARRISON NORTH BETWEEN SECS 19 & 20
1980 LEAVE TIMBER & ENTER PRAIRIE
2640 QUARTER SEC COR IN SMALL PATCH OF HAZEL. SET A POST &
RAISED MOUND
5280 COR TO SECS 17,18,19,20 IN EDGE OF RAVINE CRS S.W. SET
POST & RAISED MOUND.
EAST ON RAND BET 17 & 20
2640 TEMPY 1/4 SEC COR
5288.58 INT. E BOUNDARY 35.64 NORTH OF POST.
COR. WEST BET 17 & 20
2644.29 QUARTER SEC COR ON SUMMIT OF RIDGE N & S.
5288.58 SEC COR.
WEST BETWEEN 18 & 19 ON RAND.
2640 TEMPY 1/4 SEC COR
3630 LEAVE PRAIRIE & ENTER TIMBER
5197.5 INT. W BOUNDARY 59.4' SOUTH OF POST IN EAST EDGE OF
MARSH {SET COR TO SECS 18 & 19 MARKED POST.
2640 QUARTER SEC COR. ON GROUND DESCENDING SOUTH POST &
RAISED MOUND
3544.2 TRAIL TO TURTLE VILLAGE
5280 COR TO SEC 7,8,17,18 ON NORTHERN ? OF HIGH GROUND.
1967 BATTERMAN VOL 4 PG 344 REFERENCED SAME.
1970 SHIMEALL CSM V1 PG 304 FOUND PIPE
1971 SHIMEALL SUBDIVISION PLAT BK 25 PG 35 FOUND IRON PIPE
1975 SPRAGUE MAP #427 N/S 198,251.19;E/W 2,239,766.87
1979 COMBS CSM V9 PG 94 2659.9 TO E 1/4 COR SEC 18
1990 KREBS CSM V14 PG 397 2660.4 TO E 1/4 COR SEC 18. FOUND PIPE

FOUND 3" PIPE.

C) Was the corner restored through acceptance of (1) an obliterated evidence location, or, (2) a found perpetuated location?
ACCEPTED FOUND PIPE.

D) Describe any material discrepancy between the location of the corner as restored or reestablished and the location of that corner as previously restored or reestablished by distance and direction. Show the discrepancy on the plan view drawing under (a), above. Show the distances between the corner as previously restored or reestablished and (1) the corner as restored or reestablished, and (2) to at least 4 of the witness monuments shown on the drawing in (a), above.

(E) Was the corner reestablished through lost corner proportionate methods? If so, show the method, including the directions and distances to other public land survey corners used as evidence or used for proportioning the corner location.
NO

I, Donald Barnes, hereby certify that the corner points as identified by the corner code index were, in a field survey on, established, re-established, monumented, re-monumented, recovered or restored as expressed below and in conformance with the regulations and rules as required in the current manual of survey instructions of the United States Department of Interior, Bureau of Land Management.

COUNTY SURVEYOR FILING DATA

Date of computer entry _____

Date microfilmed _____

Number of included sheets _____
CORNER CODE


EMBOSS LAND SURVEYOR SEAL

A-E 7.08 REQUIREMENT

N-5

Donald Barnes
seal
Oct 9, 1998

8691620
 Donald Barnes
 Oct 9, 1998

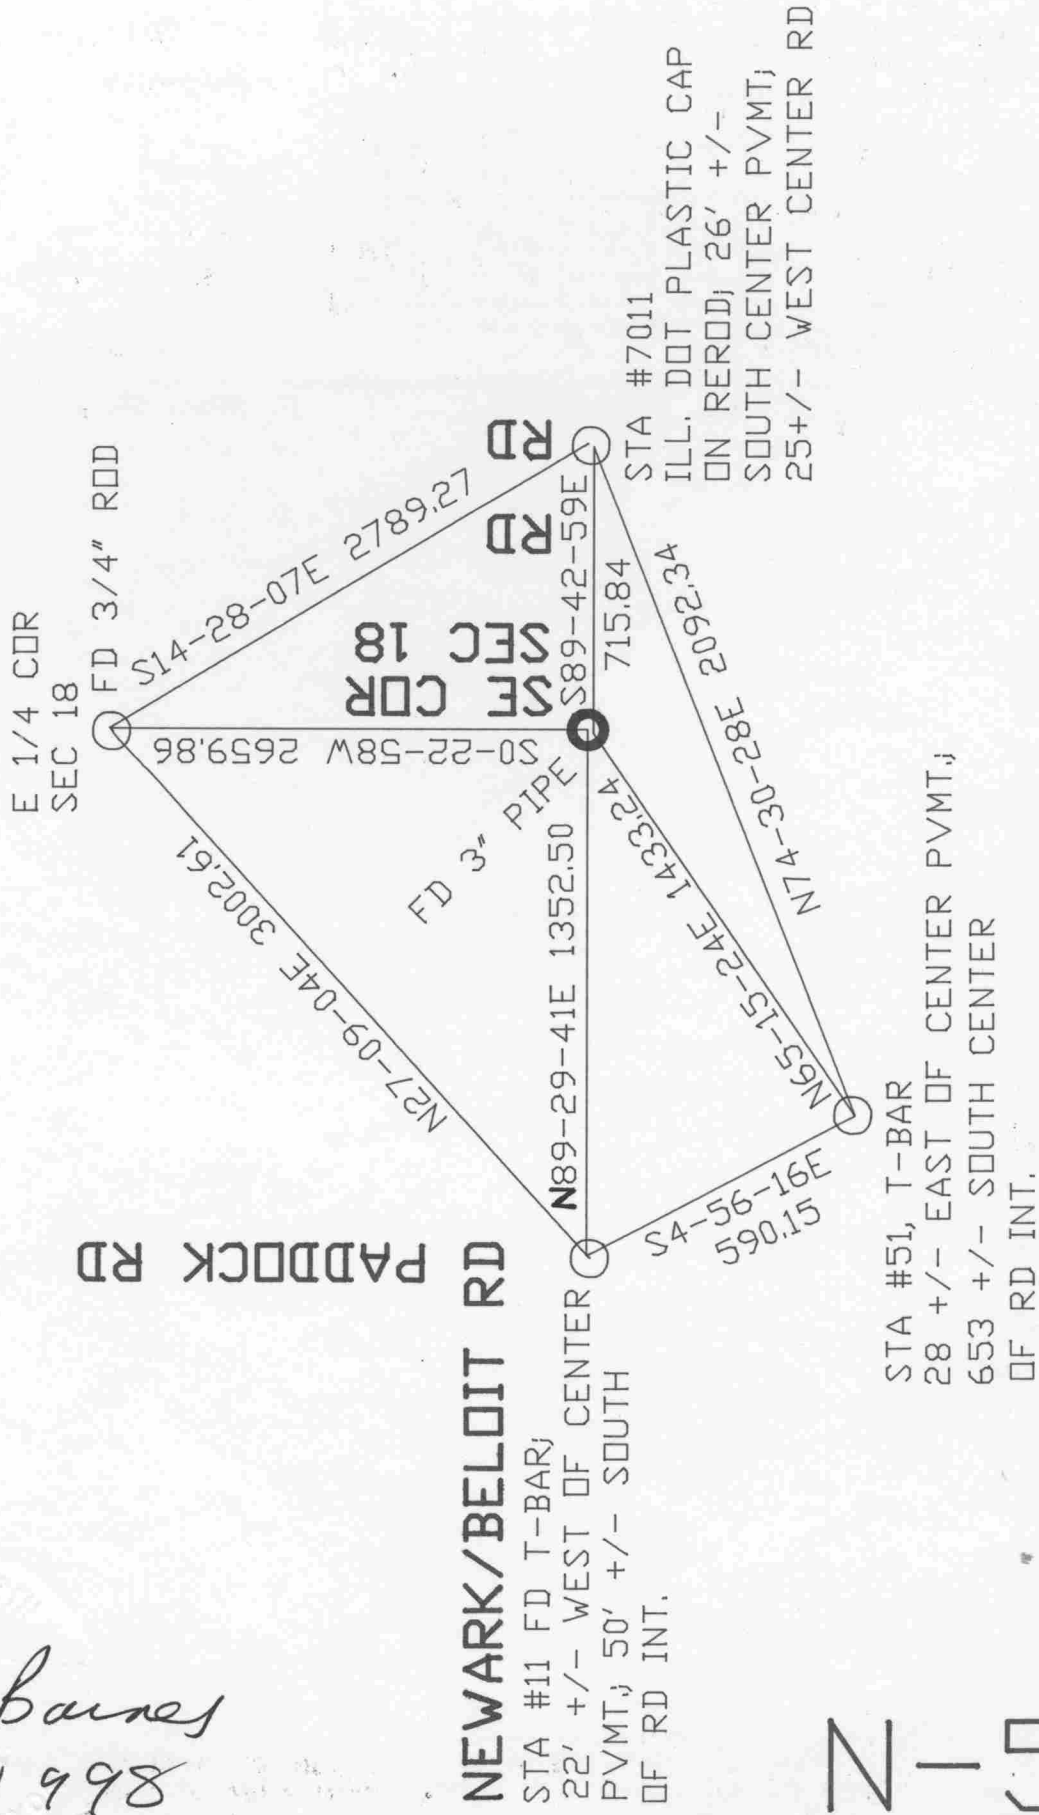

N 15

