
U.S.

required PUBLIC LAND SURVEY MONUMENT RECORD

For Public Land Survey Corners in: T. _/N., R. _/2_E

WI ADMINISTRATIVE CODE A-E 7.08 REQUIREMENT

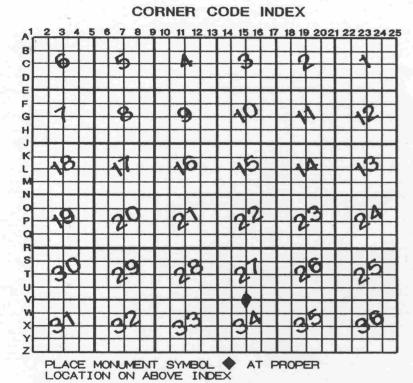

BELOTT TWP ROCK COUNTY WI

IF AVAILABLE ROCK COUNTY COORDINATES PERFERRED

North 206,407.87 Elev.

East 482,917.46

Hor. Datum County Vert. Datum

ELLIPS. HT. LATITUDE

LONGITUTE

GPS (X) __ TRAVERSE (X) __

BASED ON THE FOLLOWING CONTROL:

♦ CORNER MONUMENT

O WITNESS MONUMENT

BEARINGS ARE BASED

(a)

FIELD BOOKPAGE #	SHEET OF 3
SHOW A PLAN VIEW DRAWING DEPICTING PHYSICAL FEATURES, INCLUDING THE EXCA	THE CORNER MONUMENT AND SURROUNDING AVAIION AREA AND DEPTH.
PLANNING & ZONING COMMITTEE ADOPTED THE AB	OVE FORM ON 12/2/1982
	CORNER CODE V-15

BE608

(B) Describe any record evidence, monument evidence, occupational evidence, testimonial evidence or any other material evidence you considered, and whether the monument was found or placed.

1834 HARRISON EAST ON RANDOM BETW. SECS 22 & 27

1980 ENTER LOW LEVEL GROUND

2640 TEMPY 1/4 SEC. COR.

5214 INT. EAST BOUNDARY 7.92' N OF POST LAND GENERALLY LEVEL. WEST BET. SECS 27 & 34

2607 SET QUARTER SEC CORNER ON GROUND SLOPING OFF GRADUALLY TO THE N.E. SET POST & RAISED MOUND

5214 INT. SEC COR.

- 1902 WILSON SUBDIVISION PLAT BK 6 PG 55 BURIED QUARRY ROCK WITH HOLES DRILLED INTO TOP SURFACE. 33 NORTH OF THE SOUTH ROW LINE OF LIBERTY, 33 WEST OF EAST ROW LINE OF CHERRY ST., 1326.67 TO W 1/16TH COR OF NE 1/4 OF SEC 34, 672.5 TO ROCK AT INTERSECTION OF LIBERTY & AVENUE B (WEST OF CORNER), 342.5 TO CENTER LINE OF AVENUE C (WEST OF CORNER), 332.1 TO ROCK AT CENTER LINE OF AVENUE A (EAST OF CORNER)
- 1920 BATTERMAN SR. SUBDIVISION PLAT BK 10 PG 17 FOUND STONE MONUMENT AT CORNER. 2612 FROM THE S 1/16TH COR OF THE SW 1/4 OF SEC 27 TO SW CORNER SEC 27, ANGLE OF 90-05-00 FROM THE W 1/4 COR SEC 27 TO S 1/4 COR SEC 27, ANGLE OF 89-58 FROM SW COR SEC 27 TO CENTER OF SEC 27, & ANGLE OF 89-44 FROM CENTER OF SEC 27 TO SOUTH LINE OF THE SE 1/4 OF SEC 27. CALLS FOR STONE 33 NORTH OF SOUTH ROW, 33 WEST OF EAST ROW OF TOWNLINE ROAD, 30 EAST OF WEST ROW LINE OF TOWNLINE ROAD TO THE NORTH.

1926 SHIMEALL CITY OF BELOIT NOTES GAS PIPE REFERENCED TO LOT CORNERS. 44.73 NE TO LOT (GP), 44.22 NW TO LOT (GP), 46.94 SW TO LOT (GP), & 46.83 SE TO LOT (GP).

- 1948 BATTERMAN SR. SUBDIVISION PLAT "McGAVOCK HEIGHTS" BK 15 PG 11 SHOWS A MONUMENT AT CORNER BUT DOES NOT STATE TYPE OF MONUMENT.1306.00 TO CENTER OF DIVISION ST & LIBERTY ST., 581.20 TO CENTER OF MERRILL AVE & TOWNLINE RD. 30 EAST OF THE WEST ROW LINE OF TOWNLINE RD, 33 WEST OF THE EAST ROW LINE OF TOWNLINE RD, 33 NORTH OF THE SOUTH ROW LINE OF LIBERTY ST, 33 SOUTH OF THE NORTH ROW LINE OF LIBERTY ST.,& ANGLE OF 90-59-00 FROM N/S CENTER LINE OF SEC 34 TO THE NORTH LINE OF THE NE 1/4 SEC 35.
- 1931 VOL 3 PG 189 FD IRON ROD MON IN ROUND CI BOXES (IN SE & NE RD INTERSECTION) 66' APART.

1962 BATTERMAN CSM V1 PG 71 FOUND PIPE

1964 BATTERMAN CSM V 1 PG 99 FOUND 1" PIPE

- 1967 LEE CSM V 1 PG 143 SHOWED CORNER AT CENTER OF STREET INTERSECTION.
- 1970 LEE CSM V 1 PG 305 SHOWED CORNER ALONG CENTER LINE OF LIBERTY ST & PK @ CORNER.

1970 LEE CSM V 1 PG 321 SHOWS MONUMENT AT CORNER.

1970 LEE SUBDIVISION PLAT BK 25 PG 19 CALLS FOR A DISTANCE TO PLAT.

DID NOT FIND A MONUMENT. ESTABLISHED CORNER FROM LOT CORNERS OF ADJACENT SUBDIVISION PLATS. DID NOT PLACE MONUMENT BECAUSE ROAD WILL BE REBUILT.

- C) Was the corner restored through acceptance of (1) an obliterated evidence location, or, (2) a found perpetuated location?
 ACCEPTED FOUND PERPETUATED LOCATION.
- D) Describe any material discrepancy between the location of the corner as restored or reestablished and the location of that corner as previously restored or reestablished by distance and direction. Show the discrepancy on the plan view drawing under (a), above. Show the distances between the corner as previously restored or reestablished and (1) the corner as restored or reestablished, and (2) to at least 4 of the witness monuments shown on the drawing in (a), above.

 NONE.

V-15

(E) Was the corner reestablished through lost corner proportionate methods? If so, show the method, including the directions and distances to other public land survey corners used as evidence or used for proportioning the corner location.

I, Donald Barnes, hereby certify that the corner points as identified by the corner code index were, in a field survey on, JULY 16, 1997, established, re-established, monumented, re-monumented, recovered or restored as expressed below and in conformance with the regulations and rules as required in the current manual of survey instructions of the United States Department of Interior, Bureau of Land Management.

COUNTY SURVEYOR FILING DATA

seal

Date of computer entry____

Date microfilmed _____

Number of included sheets

CORNER CODE

A-E 7.08 REQUIREMENT

EMBOSS LAND SURVEYOR SEAL Paines

V-15

