Paper weight


Black non_____required

PUBLIC LAND SURVEY U.S. MONUMENT RECORD

For Public Land Survey Corners in:

WI ADMINISTRATIVE CODE A-E 7.08 REQUIREMENT

T. _LN., R. 12 E

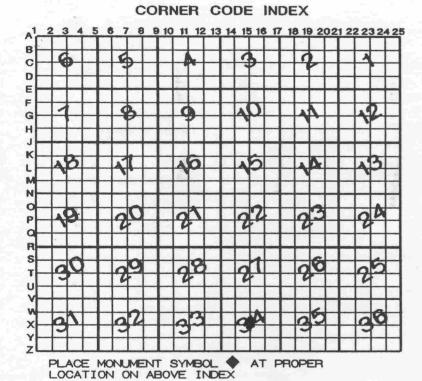

BELOIT TWP ROCK COUNTY WI

IF AVAILABLE ROCK COUNTY COORDINATES PERFERRED

North 203,756.44 Elev.

East 482, 937,42

Hor. Datum County Vert. Datum _

LATITUDE

ELLIPS. HT.

LONGITUTE

GPS (X) __ TRAVERSE (X) __

BASED ON THE FOLLOWING CONTROL:

♦ CORNER MONUMENT

O WITNESS MONUMENT

BEARINGS ARE BASED

(a)

FIELD BOOKPAGE #	SHEET		2
SHOW A PLAN VIEW DRAWING DEPICTING THE CORNER MONUMENT APPLYSICAL FEATURES, INCLUDING THE EXCAVATION AREA AND DEPTH		OUNDING	
PLANNING & ZONING COMMITTEE ADOPTED THE ABOVE FORM ON 12/2/1982			
CORNER	CODE	X-15	

BE4617 CENTER SEC 34

(B) Describe any record evidence, monument evidence, occupational evidence, testimonial evidence or any other material evidence you considered, and whether the monument was found or placed.

1857 CHURCH BK 3 PG 25 ANGLE OF 90-24 AT E 1/4 COR SEC 34 FROM EAST LINE OF SE 1/4 TO E/W CENTER LINE OF SEC 34. STATES NOTHING ABOUT CENTER. SURVEY IS NEAR E 1/4 COR SEC 34.

1893 WILSON BK 5 PG 11 1329.58 FROM S 1/16TH OF NE 1/4 TO E 1/4 COR SEC 34 & ANGLE OF 89-30 FROM E/W CENTER LINE TO NE COR SEC 34 AT E 1/4 COR SEC 34. STATES NOTHING ABOUT CENTER OF SECTION. CALLS FOR ROCK AT S 1/16TH COR OF NW 1/4 OF SEC 34.

1902 WILSON BK 6 PG 50A 1313.32 TO S 1/16TH OF NW 1/4 & 1331.90 TO E 1/16TH OF SW 1/4. CALLS FOR ROCK

1902 WILSON BK 6 PG 55 1326.67 FROM N 1/4 TO E 1/16TH COR OF NW 1/4 OF SEC 34. CALLS FOR ROCK.

1911 HAEBIN BK 9 PG 4 1315.25 TO S 1/16TH OF NW 1/4 & 1326.0 TO E 1/16TH OF NW 1/4. CALLS FOR STONE ON DRAWING BUT CALLS FOR GAS PIPE IN NARRATIVE.

1939 SHIMEALL BELOIT CITY RECORDS. TIES FOUND CORNER. 660.05 TO E/W CENTER OF ROOSEVELT AVE. SE 44.89 TO LOT CORNER, NE 47.(1?)3 TO LOT CORNER, NW 44.98 TO LOT CORNER, SW 44.27 TO LOT CORNER, 660.05 TO CENTER OF ROOSEVELT AVE., THE EASTER R/W TO THE NORTH IS 33.8, AND THE WESTER R/W TO THE NORTH IS 33

1940 SHIMEALL MAP #11937 ANGLE OF 89-19 AT S 1/4 COR SEC 34 FROM SOUTH LINE OF SW 1/4 TO N/S 1/4 LINE OF SEC 34, 1331.90 FROM CENTER TO E 1/16TH COR OF SW 1/4 OF SEC 34, & 1330.77 FROM S 1/4 COR TO E 1/16TH COR OF SW 1/4 OF SEC 34.

1940 SHIMEALL Z-13 CALLS FOR 1330.77 FROM S 1/4 COR TO E 1/16TH CORNER OF SW 1/4 SEC 34, 1331.90 FROM E 1/16TH CORNER OF SW 1/4 TO CENTER OF SEC 34, AND ANGLE OF 89-19 AT THE S 1/4 COR SEC 34 FROM THE N 1/4 COR SEC 1 T46N R1E. STATES NOTHING ABOUT CENTER OF SEC 34.

1948 BATTERMAN BK 15 PG 11 ANGLE OF 90-59-0 AT N 1/4 COR SEC 34 FROM N/S 1/4 LINE TO NORTH LINE OF NW 1/4 OF SEC 34. STATES NOTHING ABOUT CENTER OF SEC 34.

CORNER IS ON M.H. COVER. 1.1 WEST OF EAST EDGE & CENTER OF N/S PAVEMENT. DID NOT PLACE MONUMENT BECAUSE OF THE M.H. ESTABLISHED CORNER FROM LOCAL MONUMENTS OF SUBDIVISION PLATS. SEE DIAGRAM

- C) Was the corner restored through acceptance of (1) an obliterated evidence location, or, (2) a found perpetuated location? CORNER RESTORED THROUGH ACCEPTANCE OF OBLITERATED EVIDENCE LOCATION
- D) Describe any material discrepancy between the location of the corner as restored or reestablished and the location of that corner as previously restored or reestablished by distance and direction. Show the discrepancy on the plan view drawing under (a), above. Show the distances between the corner as previously restored or reestablished and (1) the corner as restored or reestablished, and (2) to at least 4 of the witness monuments shown on the drawing in (a), above.
- (E) Was the corner reestablished through lost corner proportionate methods? If so, show the method, including the directions and distances to other public land survey corners used as evidence or used for proportioning the corner location.

I,DONALD BARNES, hereby certify that the corner location as identified by the corner code index was determined by me under by direction and control and that this U.S. Public Land Survey Monument Record is correct and complete to the best of my knowledge and belief.

Oct 8, 1997

emboss/stamped

Number of included sheets

4-15

