
## U.S. PUBLIC LAND SURVEY MONUMENT RECORD

For Public Land Survey Corners in the T. N., R./ZE.

CORNER CODE INDEX

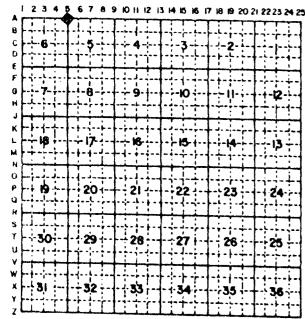

PLACE MONUMENT SYMBOL (\*) AT PROPER LOCATION ON ABOVE INDEX

EXAMPLE

A-4

ROCK COUNTY WI

D-8/4

IF AVAILABLE STATE PLANE COORDINATES

North (Y) 233,3/8,52 Eleve. (2)

East (X) 469, 759,95 Zone


Hor. Datum \_\_\_\_\_ Vert. Datum

CORNER MONUMENT

O WITNESS MONUMENT



e.)

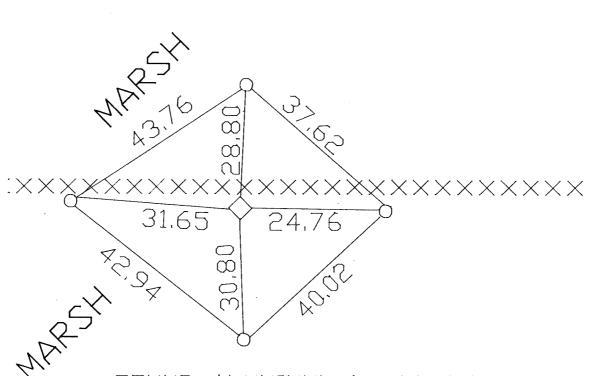

FOUND ALUMINUM MONUMENT.

PLACED CARSONITE POST NEXT TO MONUMENT.

01/2X24 REROD FIELD BOOK #3 PG 15

SHEET\_\_\_ OF\_\_\_

CORNER CODE: AS

(B) Describe any record evidence, monument evidence, occupational evidence, testimonial evidence or any other material evidence you considered, and whether the monument was found or placed.

1834 HARRISON ORIGINAL GOVERNMENT SURVEYOR. FIELD NOTES - INTERSECTED N BOUNDARY 204.6 WEST OF POST IN MARSH. SET POST AND RAISED MOUND.

1870 RUGER VOL 2 PG 45. FOUND OLD STAKE. SET LIMESTONE 14X8X3. SHOWS 204.6' TO SE CORNER OF SEC 31 AND 2652.32 TO THE N 1/4 CORNER OF SECTION 6.

1981 BARNES VOL 6 PG 167 DUG AND FOUND STONE OF RECORD. REPLACED STONE WITH ALUMINUM.

FOUND ALUMINUM MONUMENT. PLACED CARSONITE POST NEXT TO MONUMENT.

- C) Was the corner restored through acceptance of (1) an obliterated evidence location, or, (2) a found perpetuated location?
  ACCEPTED FOUND MONUMENT.
- D) Describe any material discrepancy between the location of the corner as restored or reestablished and the location of that corner as previously restored or reestablished by distance and direction. Show the discrepancy on the plan view drawing under (a), above. Show the distances between the corner as previously restored or reestablished and (1) the corner as restored or reestablished, and (2) to at least 4 of the witness monuments shown on the drawing in (a), above.
- (E) Was the corner reestablished through lost corner proportionate methods? If so, show the method, including the directions and distances to other public land survey corners used as evidence or used for proportioning the corner location.
- I, Donald Barnes, hereby certify that the corner points as identified by the corner code index were, in a field survey on, July 23,1990, established, re-established, monumented, remonumented, recovered or restored as expressed below and in conformance with the regulations and rules as required in the current manual of survey instructions of the United States Department of Therepior, Bureau of Land Management.

Seal of Daniel D

COUNTY SURVEYOR FILING DATA

Date of computer entry\_\_\_\_\_

Date microfilmed \_\_\_\_\_

Number of included sheets

AFFIX YOUR LAND SURVEYOR SEAL

CORNER CODE A 5