Paper	weigh

__ninimum)


Black no_____ required

U.S.

PUBLIC LAND SURVEY MONUMENT RECORD

For Public Land Survey Corners in: T. _(N., R. _/2E

WI ADMINISTRATIVE CODE A-E 7.08 REQUIREMENT

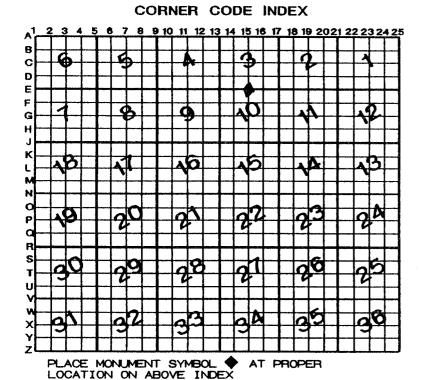

BELO	1	TWI
ROCK	COUNTY	WI

IF AVAILABLE ROCK COUNTY COORDINATES PERFERRED

North 227,675.85 Elev. East 483,110,91

Hor. Datum _____ Vert. Datum ____

LATITUDE ELLIPS. HT.

GPS (X) __ TRAVERSE (X) __

BASED ON THE FOLLOWING CONTROL:

LONGITUTE

♦CORNER MONUMENT

O WITNESS MONUMENT

BEARINGS ARE BASED ON:

(a)

FIELD BOOKPAGE #	S	HEET		OF	2_
SHOW A PLAN VIEW DRAWING DEPICTING THE CORNER MONUMENT A	AND	SURRO	UNDING		
PHYSICAL FEATURES, INCLUDING THE EXCAVATION AREA AND DEPTH.					
PLANNING & ZONING COMMITTEE ADOPTED THE ABOVE FORM ON 12/2/1982					

CORNER CODE E-15

BE528

(B) Describe any record evidence, monument evidence, occupational evidence, testimonial evidence or any other material evidence you considered, and whether the monument was found or placed.

1834 HARRISON MARCH 19th ORIGINAL SURVEY EAST ON RANDOM BETWEEN SEC 3 & 10

1848 LEAVE PRAIRIE & CENTER N. POINT OF TIMBER

2442 LEAVE TIMBER & ENTER PRAIRIE

2640 TEMPY 1/4 SEC COR.

4059 BROOK 6.6' CRS S.E.

5286.6 INT E. BDY 7.92'S OF POST. LAND ? TIMBER ? 1ST RATE PRAIRIE TIMBER RED & W.O., THE BROOK MENTIONED AT 4059 IS A FINE STREAM WITH A GRAVELLY BOTTOM.

WEST COR BET. SECS 3 & 10

2643.3 QUARTER SEC CORNER ON GROUND DESCENDING N.E. TO CREEK. POST & RAISED MOUND

3432 A RED O. 14 IN DIAM

5286.6 INT. SEC. COR.

1851 McVEAN VOL 1 PG 2 2671.02 TO SW COR SEC 3, 2615.58 TO SE COR SEC 3, 5349.96 TO S 1/4 COR SEC 10.

1874 RUGER VOL 2 PG 143 STAKE DEEP IN PLACE OF OLD ONE 20X14X12 SURROUNDED BY 4 STONES. INTERSECTION OF FENCES. 2636.04 TO SE COR SEC 3.

1919 BATTERMAN VOL 3 PG 76 FOUND RUGERS LARGE HH SURROUNDED BY 4 HH. SET IRON ROD 1/2X1 1/2X24" ON TOP. 2636.6 TO CENTER SEC 3(WELL POINT), 2641 TO SE COR SEC 3, & ANGLE OF 90-14 AT SE COR SEC 3 FROM S 1/4 COR SEC 3 TO E 1/4 COR SEC 3.

1966 BATTERMAN VOL 4 PG 291 FOUND SLED RUNNER WHICH BATTERMAN SR. SET IN 1919 OVER RUGERS LS. SET YELLOW POST SE OF COR.

FOUND OLD SLED RUNNER. PLACED CARSONITE POST ON SOUTH SIDE.

- C) Was the corner restored through acceptance of (1) an obliterated evidence location, or, (2) a found perpetuated location? ACCEPTED FOUND PERPETUATED LOCATION.
- D) Describe any material discrepancy between the location of the corner as restored or reestablished and the location of that corner as previously restored or reestablished by distance and direction. Show the discrepancy on the plan view drawing under (a), above. Show the distances between the corner as previously restored or reestablished and (1) the corner as restored or reestablished, and (2) to at least 4 of the witness monuments shown on the drawing in (a), above.
- (E) Was the corner reestablished through lost corner proportionate methods? If so, show the method, including the directions and distances to other public land survey corners used as evidence or used for proportioning the corner location.
- I, Donald Barnes, hereby certify that the corner points as identified by the corner code index were, in a field survey on, APRIL 1998, established, re-established, monumented, re-monumented, recovered or restored as expressed below and in conformance with the regulations and rules as required in the current manual of survey instructions of the United States Department of Interior, Bureau of Land Management.

		COUNTY SURVEYOR FILING DATA	
Ond Barnes		Date of computer entry	
Verido 17 acco		Date microfilmed	
		Number of included sheets	
EMBOSS LAND SURVEYOR SEAL	A-E 7.08	REQUIREMENT E _ 15	_

