
U.S.

SURVEY TUBLIC MONUMENT RECORD

For Public Land Survey Corners in the T. 1N., R. 13E

CORNER CODE INDEX

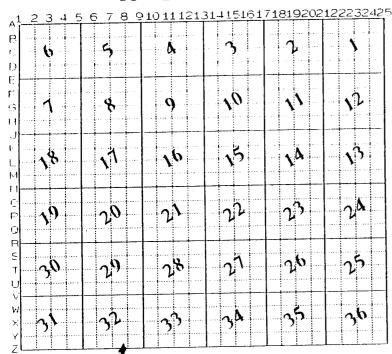

TUPTLE ROCK COUNTY WI

IF AVAILABLE ROCK COUNTY COORDITIATES PERFERRED

North 200,345,20 Elev.

504 787, 98 East

Hor. Datum <u>COUNT</u>Y Vert. Datum ____

TRAVERSE (X) GPS (X) ___ BASED ON THE FOLLOWING CONTROL:

PLACE MONUMENT SYMBOL & LOCATION ON ABOVE INCEX

OCORNER MONUMENT

O WITHESS MONUMENT

BEARINGS ATE BASED ON:

(a)

FIELD BOOK

PAGE #

SHOW A PLAN VIEW DRAWING DEPICTING THE COTHER MONDENT AND SUPPOLIDING PHYSICAL FEATURES, INCLIDING THE EXCAVATION AREA AND DEPTH. THE COFINER MONDENT SHALL HAVE
THE FOLLOWING CHARACTERISTICS: 11 HAVE A LEAST TWO PREDETERMINED BREAK-COFF POTITIS. 21 IF BROKEFL LEAVE A PERHAMENTLY MARKETIZED REMAINT AT THE ORIGINAL POINT.
23 MUST BE EXTENDABLE. 40 THE CAP IS HISCRIBED TROCK COUNTY SURVEY MONDENT - PENALTY FOR DISTURBING MARKER. 51 OR AN EXISTING CUT LINESTONE. AN IRON PIPE 1 1/2"Y

34 MUST PE EXTENDABLE. 40 THE CAP IS HISCRIBED TROCK COUNTY SURVEY MONDENT - PENALTY FOR DISTURBING MARKER. 51 OR AN EXISTING CUT LINESTONE. AN IRON PIPE 1 1/2"Y

35 MUST PE EXTENDABLE. 40 THE CAP IS HISCRIBED TROCK COUNTY SURVEY MONDENT OF THE SURVEY. IF THE COPINER IS OCCUPIED BY AN INFROVEMENT MAPPLEBURIED CABLESTO. AND

4* INTINITUAL HAVE BE USED 111 AREAS WHERE OFFICIAL WARE IS WITHIN DOME FOOT OF THE SURVEY. IF THE COPINER IS OCCUPIED BY AN INFROVEMENT MAPPLEBURIED CABLESTO. AND

4* INTINITUAL HAVE BE USED 111 AREAS WHERE OFFICIAL BY THE SURVEY. IT THE COPINER AND THE WITHESS MONDENTS SHALL BE MADE OF CONDITION.

51 ONE IRON OF OTHER EQUÂLLY DURABLE MATERIAL EXCEPT WOOD DESCRIBE THE COPINER AND THE WITHESS MONDENTS.

ELAIBING & ZONITKO COMMITTEE ADOPTED THE ABOVE FORM ON 12/2/1982 WI ADMINISTRATIVE CODE A-E 7.08 REQUIREMENT

SHEET _ / _ OF _ Z

NW 2 4003

- (B) Describe any record evidence, monument evidence, occupational evidence, testimonial evidence or any other material evidence you considered, and whether the monument was found or placed.
- 1836 SPALDING FIELD NOTES PG 391&392. INTERSECTED BASE LINE OF NORTH WEST TERRITORY 1963.5' WEST OF THE CORNER TO SECTIONS 33&32 T1N R13E OF 4TH PM. & AT SAID INTERSECTION SET A POST & STONE 16"LONG 6" WIDE & 4" THICK FOR CORNER TO SEC 2&3 T46N R2E OF 3 PM.
- 192? TISSANDIER MAP 5462.70 TO NE COR SEC 2, 5367.70 TO NW COR SEC 3, AN ANGLE OF 179-21-19 FROM THE NE COR SEC 2 TO THE NW COR SEC 3, LAT 42-30-17.95", & LONG 89-00-12.68"
- 1991 LEE VOL 6 PG 413 FOUND CONC. MON. CALLS FOR 1994.31' TO SE COR SEC 32,2678.73 TO N 1/4 COR SEC 3 T46N R2E,ANGLE OF 178-28-22 FROM SE COR SEC 32 TO N 1/4 COR SEC 3 AT NE COR SEC 3, ANGLE OF 179-51-01 AT SE COR SEC 32 FROM S 1/4 COR SEC 33 TO NE COR SEC 3.

FOUND BRASS ROD IN CONCRETE MONUMENT IN E/W FENCE LINE. PLACED CARSONITE POST NEXT TO MONUMENT. 5465.13 TO NE COR SEC 2.

- C) Was the corner restored through acceptance of (1) an obliterated evidence location, or, (2) a found perpetuated location?
 ACCEPTED FOUND PERPETUATED LOCATION.
- D) Describe any material discrepancy between the location of the corner as restored or reestablished and the location of that corner as previously restored or reestablished by distance and direction. Show the discrepancy on the plan view drawing under (a), above. Show the distances between the corner as previously restored or reestablished and (1) the corner as restored or reestablished, and (2) to at least 4 of the witness monuments shown on the drawing in (a), above.
- (E) Was the corner reestablished through lost corner proportionate methods? If so, show the method, including the directions and distances to other public land survey corners used as evidence or used for proportioning the corner location.

I, Donald Barnes, hereby certify that the corner points as identified by the corner code index were, in a field survey on,1994, established, re-established, monumented, re-monumented, recovered or restored as expressed below and in conformance with the regulations and rules as required in the current manual of survey instructions of the United States Department of Interior, Bureau of Land Management.

COUNTY	SURVEYOR	FILING	рата
COOMIT	DOKABIOK	1 111110	DAIA

seal

Date of computer entry____

Date microfilmed

Number of included sheets _____

EMBOSS LAND SURVEYOR SEAL

7/12/95

2 7/8

ILLINOIS ORIGINAL GOVERNMENT FIELD NOTES T46N R2&3E CERTIFICATE DEC 29,1836

D.A. SPAULDING WILLIAM TOP JAMES THOMAS R. WALLER HENRY CHANDLER

DL
CH CHAINMAN
CHAINMAN
FLAGMAN
AXE MAN

ALL CORNER POSTS WERE INSERTED 2' INTO A HOLE DUG IN THE GROUND WITH AN AXE & SPADE THROUGH THE FROST & THEY WERE SECURELY RAMMED IN WITH EARTH. THE STONES USED FOR CORNERS WERE OBTAINED AT DIFFERENT QUARRIES IN THE ?? AND WERE SET 1 1/2 THEIR LENGTH IN THE GROUND & ON ALL THE N/S LINES, THEY WERE SET THE WEST SIDE OF THE POSTS & EDGES FACING N/S AND ON THE E/W LINES THEY WERE SET THE NORTH SIDE OF THE POSTS & EDGES FACING E & W.

THE SAID POSTS WERE OF THE MOST DURABLE WOOD THAT COULD BE HAD IN THE LAND GENERALLY BURR OAK. THE SECTION POSTS WERE 5' LONG & WERE NOT LESS THAN 5" IN DIA., THAT THEY WERE NEATLY SQUARED AT TOP & THEN PLACED WITH THE CORNERS TO THE CARDINAL POINTS. (CONTINUES WITH OTHER STATEMENTS).

PAGE 857. DEC 26, 1838 MEASURED CHAIN COMPARED WITH THE STANDARD CHAIN & LIST IT TO BE A HALF INCH TOO LONG. MAKE IT OF THE PROPER LENGTH.