

U.S. PUBLIC LAND SURVEY MONUMENT RECORD

For Public Land Survey Corners in:

WI ADMINISTRATIVE CODE A-E 7.08 REQUIREMENT

T. 1 N., R. 12 E

CORNER CODE INDEX

A	1	2	3	4	5	6	7	8	9	10	11	12	13	14	15	16	17	18	19	20	21	22	23	24	25
B																									
C	6																								
D		5																							
E			4																						
F				3																					
G					2																				
H						1																			
I	1																								
J		8																							
K			9																						
L				10																					
M					11																				
N						12																			
O							13																		
P								14																	
Q									15																
R										16															
S											17														
T												18													
U													19												
V														20											
W															21										
X																22									
Y																	23								
Z																		24							
																			25						
																				26					
																					27				
																						28			
																							29		
																								30	
																									31
																									32
																									33
																									34
																									35
																									36

PLACE MONUMENT SYMBOL AT PROPER LOCATION ON ABOVE INDEX

BELoit TWP

ROCK COUNTY WI

IF AVAILABLE
ROCK COUNTY COORDINATES PREFERRED

North 224,947.94 Elev. _____

East 485,675.48

Hor. Datum _____ Vert. Datum _____

LATITUDE _____ ELLIPS. HT. _____

LONGITUDE _____

GPS (X) _____ TRAVERSE (X) _____

BASED ON THE FOLLOWING CONTROL:

CORNER MONUMENT

WITNESS MONUMENT

(a)

BEARINGS ARE BASED ON:

FIELD BOOK _____ PAGE # _____

SHEET 1 OF 2

SHOW A PLAN VIEW DRAWING DEPICTING THE CORNER MONUMENT AND SURROUNDING PHYSICAL FEATURES, INCLUDING THE EXCAVATION AREA AND DEPTH.

PLANNING & ZONING COMMITTEE ADOPTED THE ABOVE FORM ON 12/2/1982

CORNER CODE G-17

BE538

(B) Describe any record evidence, monument evidence, occupational evidence, testimonial evidence or any other material evidence you considered, and whether the monument was found or placed.

- 1834 HARRISON NORTH BETWEEN SECS 10 & 11
 - 1157.64 WHITE OAK 15 IN DIAM.
 - 2640 QUARTER SEC. CORNER
 - WHITE OAK 14 N29W 29
 - WHITE OAK 12 S17W 50
 - 3207.6 WHITE OAK 12 IN DIAM.
 - 3426.72 BROOK 10 CRR S.E. A ? STREAM
 - 4455/4721.64 ALONG E LINE OF THE ENCAMPMENT OF GEN ALEXANDER'S BRIGADE
 - 4721.64 BURR O 12 IN DIAM
 - 5280 LEAVE TIMBER ENTER PRAIRIE & SET COR TO SECS 2,3,10, & 11
 - BUR OAK 18 S21E 2.18
 - BUR OAK 18 S77E 296
- 1851 McVEAN VOL 1 PG 2 2609.64 TO CENTER OF SEC 10 & 5305.08 TO W 1/4 COR SEC 10.
- 1866 LOCKE VOL 1 PG 262 FD STUMPS OF BTS & SAKE. 2630.98 TO SW COR SEC 11.
- 1867 LOCKE VOL 1 PG 305 FD STUMPS OF BTS & STAKE 2641.32 TO NW COR SEC 11 & 2630.76 TO SW COR SEC 11.
- 1874 RUGER VOL 2 PG 143 FD FENCE POST ON COR. ALSO FD STUMPS OF BTS NWBT SHOULD READ 39 INSTEAD OF 29 LKS. SET LS 18X10X2 1/2 CLOSE TO POST ON E SIDE. THE COR. IS IN LINE FENCE RUNS WEST. 2640.74 TO NE COR SEC 10.
- 1958 BATTERMAN #271 LIMESTONE IN CONCRETE. PIN 494.25 TO THE NORTH & PIN 33.00 EAST OF THAT PIN. 1317.25 TO SOUTHERN 1/16TH CORNER.
- 1966 BATTERMAN VOL 4 PG 291 FD LS PREVIOUSLY FOUND AND SURROUNDED WITH CONCRETE BY SHIMEALL. SET YELLOW POST NE OF STONE.

FOUND CUT LIMESTONE IN CONCRETE. PLACED CARSONITE POST ON NORTH SIDE. CORNER IS 7 WEST OF DIRT TRAIL.

C) Was the corner restored through acceptance of (1) an obliterated evidence location, or, (2) a found perpetuated location?
ACCEPTED FOUND PERPETUATED LOCATION.

D) Describe any material discrepancy between the location of the corner as restored or reestablished and the location of that corner as previously restored or reestablished by distance and direction. Show the discrepancy on the plan view drawing under (a), above. Show the distances between the corner as previously restored or reestablished and (1) the corner as restored or reestablished, and (2) to at least 4 of the witness monuments shown on the drawing in (a), above.

(E) Was the corner reestablished through lost corner proportionate methods? If so, show the method, including the directions and distances to other public land survey corners used as evidence or used for proportioning the corner location.
NO

I, Donald Barnes, hereby certify that the corner points as identified by the corner code index were, in a field survey on, OCTOBER 1, 1997, established, re-established, monumented, re-monumented, recovered or restored as expressed below and in conformance with the regulations and rules as required in the current manual of survey instructions of the United States Department of Interior, Bureau of Land Management.

COUNTY SURVEYOR FILING DATA *

seal
Donald Barnes
2/4/98

Date of computer entry _____

Date microfilmed _____



Number of included sheets _____

CORNER CODE

EMBOSS LAND SURVEYOR SEAL

A-E 7.08 REQUIREMENT

G 17

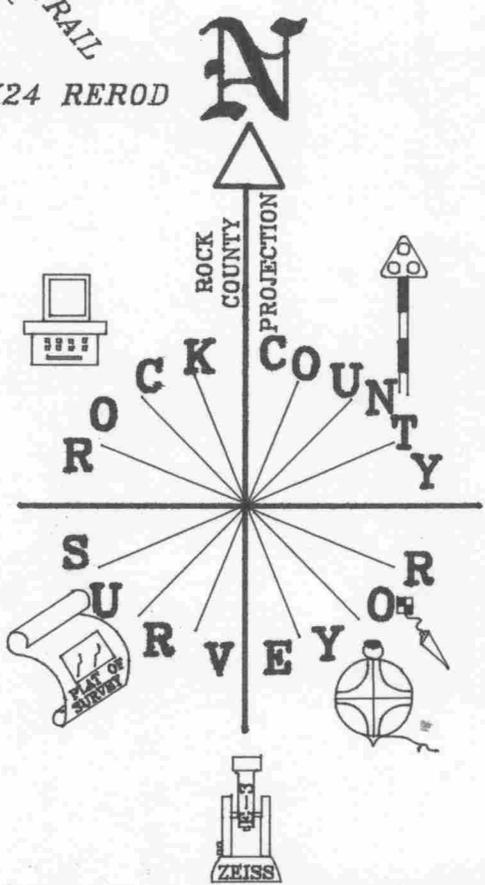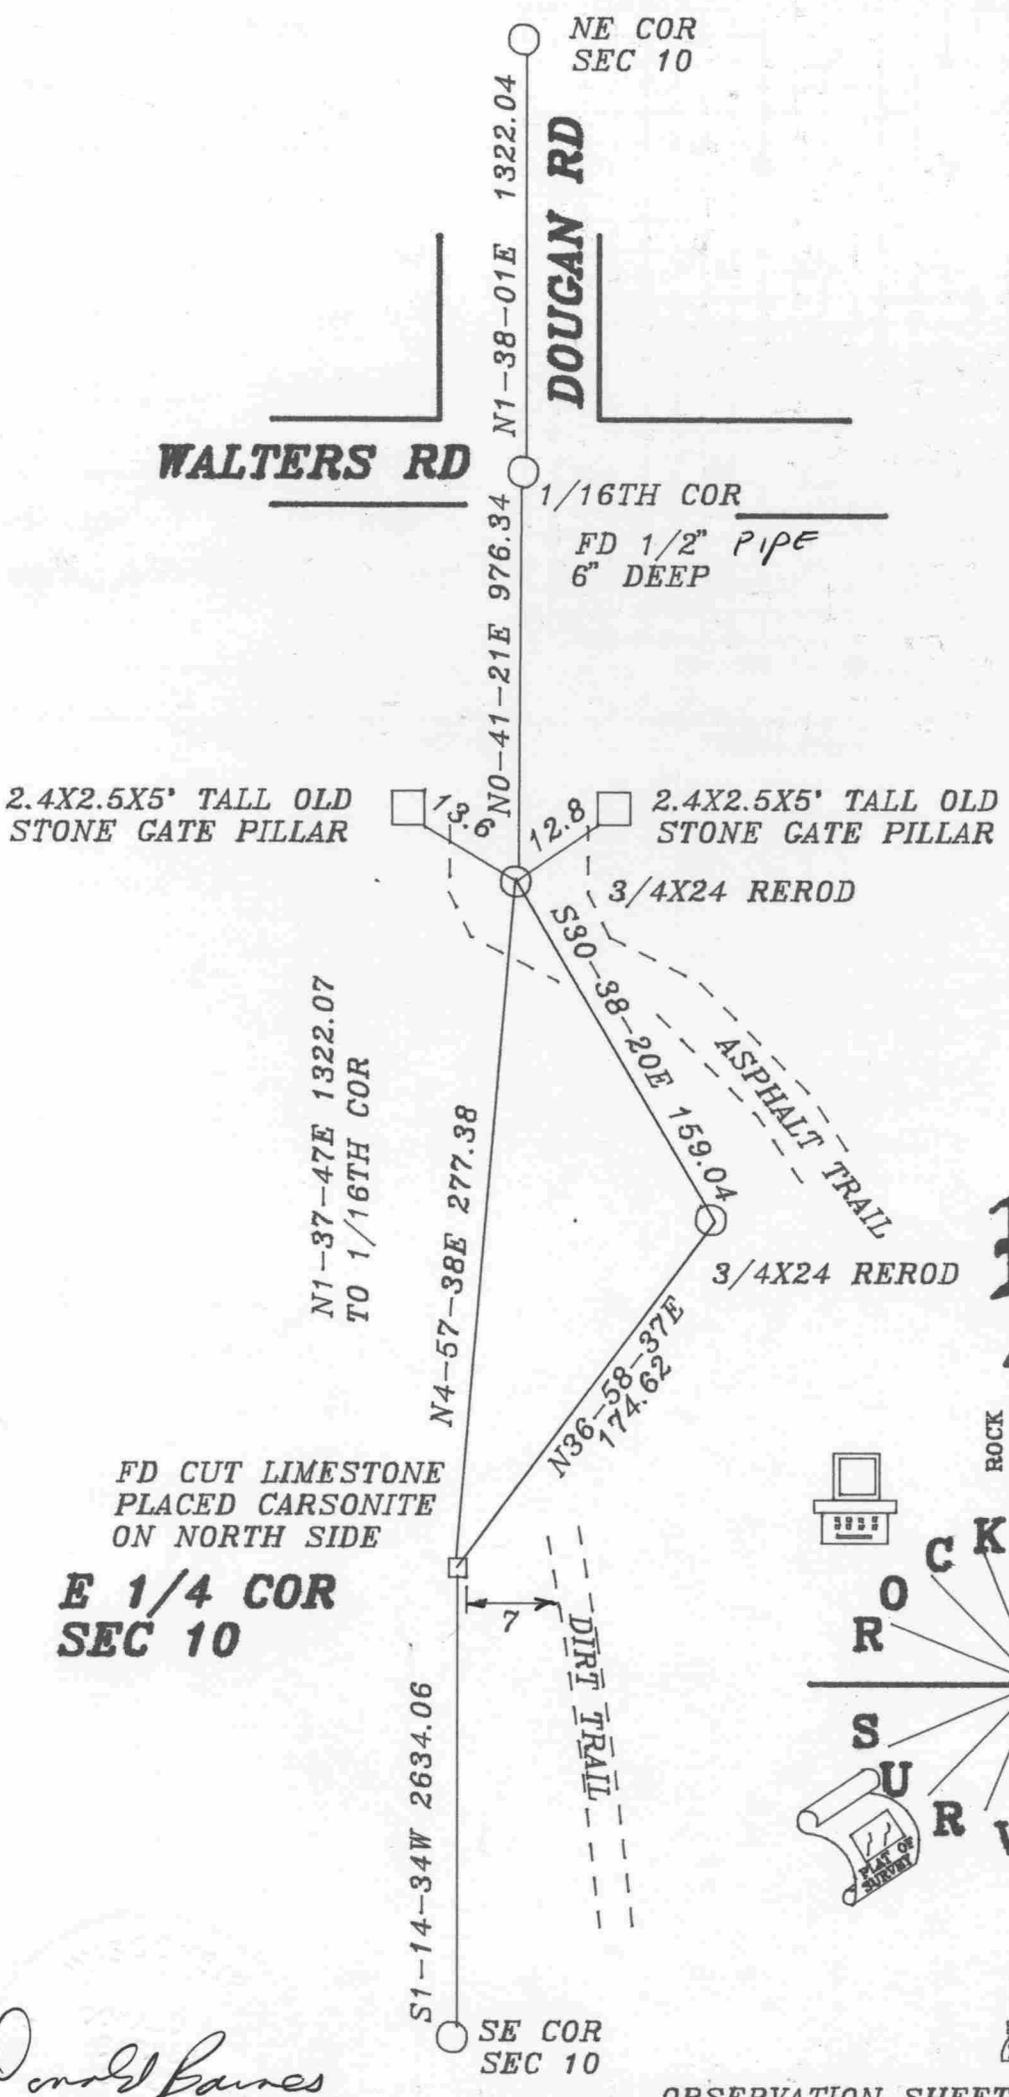

Donald Barnes
EMBOSSSED SEAL
2/4/98

OBSERVATION SHEETS 392-394
G-17