
U.S.

LAND SURVEY **PUBLIC** MONUMENT RECORD

For Public Land Survey Corners in: T./_N., R._/ZE

CORNER CODE INDEX

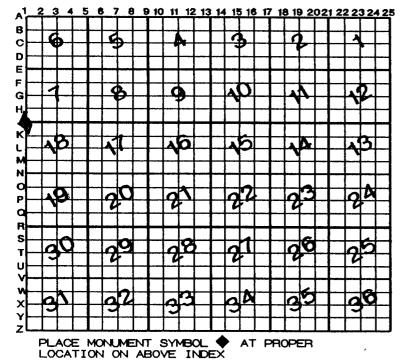

WI ADMINISTRATIVE CODE A-E 7.08 REQUIREMENT

ROCK COUNTY

IF AVAILABLE ROCK COUNTY COORDINATES PERFERRED

North 222, 695,76 Elev.	
East 464,572,10	
Hor. Datum <u>CouNTY</u> Vert. Datum	-
LATITUDEELLIPS. HT	Γ.
LONGITUTE	
GPS (X) TRAVERSE (X)	
BASED ON THE FOLLOWING CONTROL:	

♦CORNER MONUMENT

O WITNESS MONUMENT

BEARINGS ARE BASED ON:

(a)

, ,	
FIELD BOOKPAGE # SHEET OF	
SHOW A PLAN VIEW DRAWING DEPICTING THE CORNER MONUMENT AND SURROUNDING	
PHYSICAL FEATURES, INCLUDING THE EXCAVATION AREA AND DEPTH.	
PLANNING & ZONING COMMITTEE ADOPTED THE ABOVE FORM ON 12/2/1982	

be541

(B) Describe any record evidence, monument evidence, occupational evidence, testimonial evidence or any other material evidence you considered, and whether the monument was found or placed.

1833 SEP. MULLETT NORTH ON EAST SIDE SECTION 13

2211 STREAM 3.96' CROSSES S.W.

2640 SET QUARTER SECTION POST BUR OAK 18 S77W 4.25; BUR OAK 18 N71 1/2W 3.83

5148' LEAVE WET PRAIRIE & MARSH

5280 SET POST CORNER SECTION 12 & 13 BUR OAK 14 N13W 22.44' & BUR OAK 12 S7E 53.46'.

LAND MOSTLY LEVEL AND WET.

1834 HARRISON WEST BETWEEN 7 & 18

2640 TEMP 1/4 COR

2712.6' TRAIL CROSSING S.E

3630' LEAVE PRAIRIE & ENTER TIMBER

5175.72' INT WEST BOUNDARY AT NORTH EDGE OF MARSH 61.38' SOUTH OF POST MARKED SAME FOR 7 & 18 LAND 1ST 3630' AS BEFORE RUN 2ND RATE WITH RED & BURR OAK TIMBER. COR TREES TO SEC 7 & 18 BURR OAK 10 N76E 123 & BUR OAK 16 S86E 133. EAST COR. EAST

2535.72' QUARTER SEC. COR IN GROUND DESCENDING WESTWARD TO MARSH. POST & RAISED MOUND

5175.72 SEC. COR.

- 1846 NEWARK TOWN ROAD RECORDS BK 1 PG 11 COMMENCING AT T THE SE COR SEC 1 THENCE N52 1/4 DEG W 13 CH AND 57 LKS THENCE N71 1/2W 41 CH AND 14LKS; THENCE S88 1/4 W 9 CH AND 85 LKS THENCE S74 & 18 MIN W 23 CH AND 35 LKS; THENCE S 89 1/4 W 56 CHA AND 5 LKS; THENCE N 57 1/2 W 102 CH AND 70 LKS TO THE NORTH LINE OF THE TOWN.
- 1847 NEWARK TOWN ROAD RECORDS BK 1 PG 24 COMMENCING AT THE 1/4 POST ON THE EAST SIDE OF SEC 12 THENCE RUNNING WEST ON THE 1/43 SEC LINE 35 CH THENCE N66-15W 48 CH AND 20 LKS TO WHERE IT INTERESECTS A HIGHWAY . VAR OF THE NEEDLE 6-30.
- 1847 NEWARK TOWN ROAD RECORDS BK 1 PG 20 COMMENCING AT THE NE COR OF SEC 24 T1N R11E THENCE WEST ON THE SECTION LINE ONE MILE & 28 CHS TO WHERE IT INTERSECTS A ROAD THAT IS NOW LAID. CENTERLINE IS OF 4 ROD RD.
- 1847 NEWARK TOWN ROAD RECORDS BK 1 PG 29 BEGINNING AT THE QUARTER POST ON THE EAST SIDE OF SEC 12 THENCE RUNNING WEST ON THE QUARTER LIE 35 CH THENCE N72-45' 48CH AND 25 LKS TO WHERE IT INTERSECTS A ROAD. THE ABOVE DESCRIBED LINE BE THE CENTER LINE OF A PUBLIC HIGWAY OF FOUR ROADS IN WIDTH.
- 1848 NEWARK TOWN ROAD RECORDS BK 1 PG 32 THENCE EAST TO THE QUARTER POST ON THE EAST SIDE OF SEC 36 ALSO THE SAME BEING THE EAST LINE OF NEWARK. 4 ROD ROAD
- 1849 BELOIT TOWN ROAD RECORDS BK 1 PG 111 CORNER IS BEGINNING OF DESCRIPTION
- 1849 NEWARK TOWN ROAD RECORDS BK 1 PG 100 4 ROD ROAD; CENTER LINE OF SAID HIGHWAY IS TO COMMENCE AT A POINT ON THE MADISON AND BELOIT ROAD 36 RODS SOUTH OF THE SW COR OF SEC 6 T1 R12E RUNNING THENCE DUE NORTH ONE MILE AND 36 RODS ON THE TOWN LINE BETWEEN NEWARK AND BELOIT TO THE NW COR OF SEC 6 T1 R12E
- BELOIT TO THE NW COR OF SEC 6 T1 R12E 1862 NEWARK TOWN ROAD RECORDS BK 1 PG 89 SECTION LINE IS CENTER OF CLEOPHAS R/W. (RODS WIDTH)
- 1871 COLLINS NEWARK REMONUMENTATION FIELD NOTES. NORTH ON EAST LINE OF 13. VAR 5

2293.5 BROOK

2447.94 BROOK

2456.52 BROOK

2488.2 BROOK

2547.6 BROOK 2560.8 BROOK

2663.76 SET 1/4 STONE

CONTINUED NORTH- SAME VARIATION

5327.52 SET STONE FOR CORNER 12 & 13. BY STUMP AND ROOTS OF WITNESS TREE.

EAST BETWEEN 12 & 13 VARIATION 5-30

2640.66 SET 1/4 STONE. CONTINUED EAST SAME VARIATION 5281.32 SEC CORNER.

NORTH ON EAST LINE SEC 12 VARIATION 5-30 ON OFFSET 16.5' WEST 2657.82 INTERSECTED 1/4 LINE 15.18' WEST OF CORNER. SET 1/4 STONE IN OLD MOUND. CORRECTED VARIATION 5-28

CONTINUED NORTH - VARIATION 5

5328.18' INTERSECTED SECTION LINE 2.64' EAST OF CORNER., SET STONE FOR CORNER OF 1 & 12 IN REMAINS OF MOUND. CORRECTED VARIATION 4-57

- 1878 RUGER VOL 2 PG 260 2657.16 TO W 1/4 COR SEC 18. SEE SURVEY SEC 13 NEWARK BY LOCKE. SHOWS A JOG AT THE NW,W 1/4, & SW CORNERS OF SEC 18. SUBDIVIDED SEC 18. VERIFIED JOG IN ORIGINAL COUNTY SURVEYOR'S VOL 2 PG 260 RECORDS.
- 1960 BATTERMAN VOL 4 PG 109 FOUND CUT STONE & REFERENCED SAME. CALLS FOR NAD27 N/S 209,002.45; E/W 2,234,587.59 CALLS FOR 2664.40 TO W 1/4 COR SEC 18.
- 1968 LEE CSM V1 PG 163 FOUND 1" PIPE
- 1975 SPRAGUE MAP #222 N/S 203,680.6; E/W 2,2234,597.16 2653.94 TO W 1/4 COR SEC 7 & 2500.23 TO S 1/4 COR SEC 7
- 1993 LEE MAP #11996 FOUND PIPE N0-13-13W 2654.68 TO W 1/4 COR SEC 7 & S88-54-40E 2500.26 TO S 1/4 COR SEC 7.
- 1993 COMBS CSM V17 PG 137 FOUND PIN 2500.45 TO N 1/4 COR SEC 18
- 1993 COMBS MAP #9867 FOUND PIPE

FD 1" PIPE.

- C) Was the corner restored through acceptance of (1) an obliterated evidence location, or, (2) a found perpetuated location? ACCEPTED FOUND LOCATION.
- D) Describe any material discrepancy between the location of the

corner as restored or reestablished and the location of that corner as previously restored or reestablished by distance and direction. Show the discrepancy on the plan view drawing under (a), above. Show the distances between the corner as previously restored or reestablished and (1) the corner as restored or reestablished, and (2) to at least 4 of the witness monuments shown on the drawing in (a), above.

(E) Was the corner reestablished through lost corner proportionate methods? If so, show the method, including the directions and distances to other public land survey corners used as evidence or used for proportioning the corner location.

I, Donald Barnes, hereby certify that the corner points as identified by the corner code index were, in a field survey on, established, reestablished, monumented, re-monumented, recovered or restored as expressed below and in conformance with the regulations and rules as required in the current manual of survey instructions of the United States Department of Interior, Bureau of Land Management.

COUNTY SURVEYOR FILING DATA

Date of computer entry


Date microfilmed _____

Number of included sheets _ CORNER CODE

EMBOSS LAND SURVEYOR SEAL

seal

A-E 7.08 REQUIREMENT

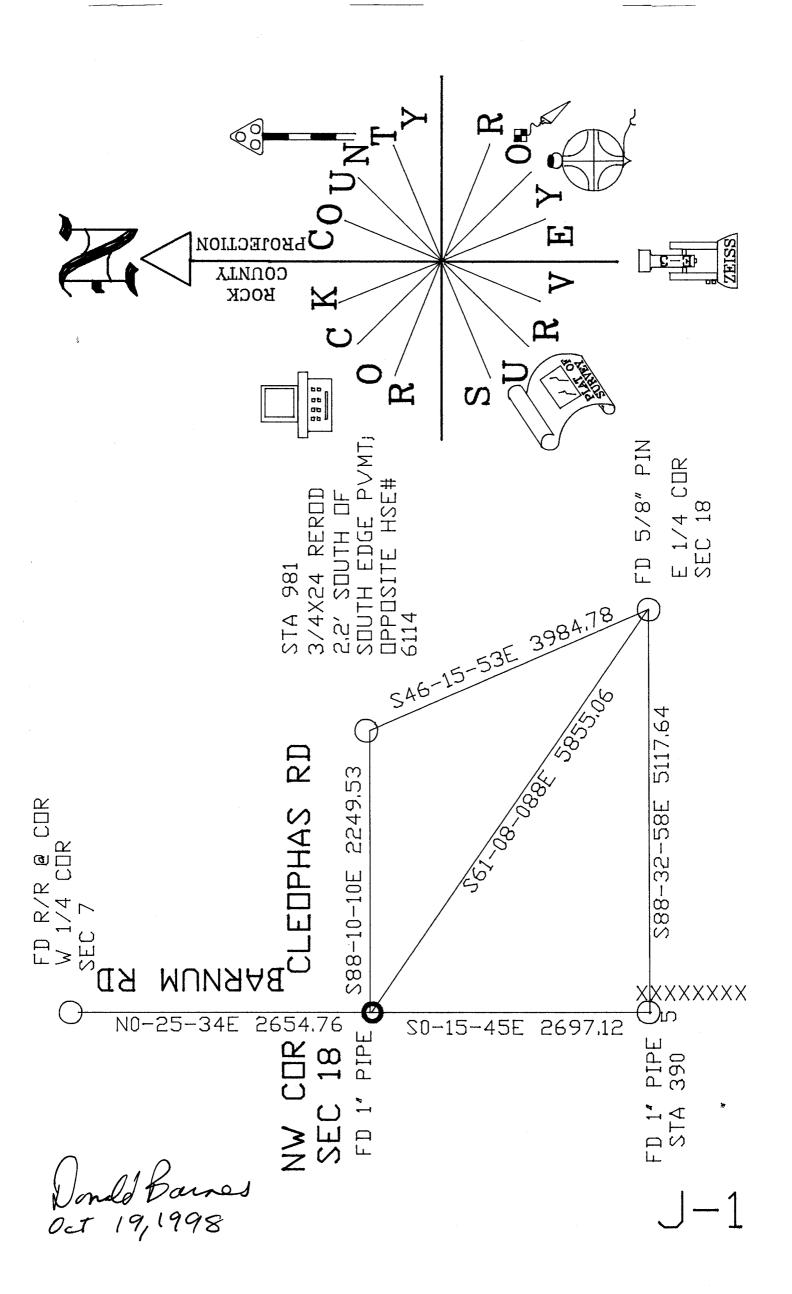

HARRISON SURVEYED THE FOLLOWING ROCK COUNTY TOWNSHIPS IN THE FOLLOWING ORDER:

	FIELD NOTE	JOGS		
	1833 ON WEST	BNDY	PLAT	ACTUAL
MARCH 14-17 1833	AVON SOUTH HALF	NO	1COR	NO
OCT 28-NOV 4 1833	PORTER	FEW	ALL	ALL
NOV 5-11 1833	UNION	YES	ALL	ALL
NOV 27-DEC 1 1833	CENTER	MOST	ALL	ALL
DEC 1-7 1833	MAGNOLIA	FEW	ALL	ALL
DEC 14-18 1833	JANESVILLE WEST HALF	NO	NO	NO
DEC 20-27 1833	PLYMOUTH	YES	NO	NO
8	1834			
JAN 26-FEB 2 1834	AVON NORTH HALF	NO	1COR	NO
MARCH 8-13 1834	NEWARK	NO	NO	NO
MARCH 13-18 1834	SPRING VALLEY	NO	\mathtt{ALL}	ALL
MARCH 16-22 1834	BELOIT WEST HALF	FEW	NO	FEW
MARCH 23-28 1834	ROCK WEST HALF	NO	NO	NO
MARCH 31 - APR 4 1834	FULTON WEST HALF	NO	NO	NO

IN CENTER & PORTER TWP ALL THE CLOSURES OF THE WEST BOUNDARY WERE LARGE AND HARRISON SPECIFICALLY STATES SETTING A POST & RAISING A MOUND FOR MANY OF THE CORNERS. THE PLAT ALLS FOR JOGS AT ALL POINTS ALTHOUGH THE FIELD NOTES DO NOT STATE SO. THE PROBLEM IS THE FIELD NOTES, ORIGINAL PLAT, AND FIELD HISTORY ARE NOT ALWAYS IN HARMONY.

THE FOLLOWING RECORDS SHOW THAT THE ORIGINAL SURVEYOR, HARRISON, PLACED N/S JOGS AT THE SECTION CORNERS BETWEEN BELOIT & NEWARK TOWNSHIPS FROM THE SW COR SECTION 31 BELOIT TOWNSHIP TO THE NW CORNER OF SEC 19. THE ORIGINAL GOVERNMENT PLAT CALLS FOR ALL THE CORNERS BETWEEN NEWARK AND BELOIT TOWNSHIPS TO BE COMMON. THE QUESTION WHY DID HARRISON CHANGE HIS FIELD PROCEDURES FOR THE NW COR SEC 18 AND THE NW COR SEC 7. THE CLOSURES WERE GREATER THAN 10.56' AT THE SW COR SEC 30 WHERE HE ESTABLISHED THE CORNER. ALSO WHY DIDN'T THE ORIGINAL PLAT REFLECT HIS JOGS AS THEY DID IN PORTER & CENTER TOWNSHIPS.

NW COR SEC 7 (COMMON) 521 E-1

1834 HARRISON FIELD NOTES WEST BETWEEN SEC 6 & 7 INT. WEST BOUNDARY 31.02' SOUTH OF POST MARKED SAME 5161.2 FOR COR TO SEC 6 & 7.

NW COR SEC 18 (COMMON) 541 J-1

1834 HARRISON FIELD NOTES WEST BET 7 & 18 5175.72 INT. WEST BOUNDARY AT NORTH EDGE OF MARSH 61.38' SOUTH OF POST MARKED SAME FOR 7 & 18

W 1/4 COR SEC 18 (JOG) 554 L-1

1878 RUGER VOL 2 PG 260 SEE SURVEY SEC 13 LOCKE. CALLS FOR E 1/4 COR SEC 13 NORTH OF THE W 1/4 COR SEC 18. 2657.16 TO NW & SW CORNERS OF SEC 18. VERIFIED MAP JOG IN ORIGINAL COUNTY SURVEYOR'S VOL 2 PG 260 RECORDS.

N-1 NW COR SEC 19 (JOG)

1834 HARRISON FIELD NOTES WEST BET. SECS 18 & 19 RAND.

INTERSECTED WEST BOUNDARY 59.4' SOUTH OF POST IN 5197.5 EAST EDGE OF MARSH SET COR TO SEC 18 & 19 MARKED POST.

1878 RUGER VOL 2 PG 260 SHOWS THE CORNER AS BEING SOUTH OF THE SE COR SEC 13 NEWARK TWP.

P-1 W 1/4 COR SEC 19 (JOG) 574 NOTHING INDICATES A JOG.

SW COR SEC 19 (JOG) 581 R-1

1834 HARRISON FIELD NOTES WEST BE. SECS 19 & 30 RAND. 5208.72 INTERSECTED WEST BOUNDARY 50.16' SOUTH OF POST COR TREES TO 19 & 30 BUR OAK 8 N49E 29' & BUR OAK 9 STOE.

J-130F5

594 T-1 W 1/4 COR SEC 30 (JOG) NOT RECORD INDICATING A JOG.

- 601 V-1 SW COR SEC 30 (JOG)
 - 1834 HARRISON WEST BETWEEN SECTIONS 30 & 31 ON RAND.
 5217.3 INTERSECTED WEST BOUNDARY 10.56' SOUTH OF POST &
 ESTABLISHED COR TO SEC 30 & 31. BEARINGS BURR OAK 30 N15E
 159 & BUR OAK 18 S29E 29
 - 1931 SUNNY VOL 3 PG 189 INCOMPLETE RECORD SEEMS TO INDICATE THAT SEC LINE OF SEC 30 & 31 BELOIT TWP JOGS 5.10 TO 16 LINKS. DUG BUT FOUND NOTHING SOUTH OF SE COR SEC 25. AT SE COR SEC 25 FOUND 6X5 CUT STONE MON. OF SEC 25 & 36 NEWARK.
- 614 X-1 W 1/4 COR SEC 31 (JOG)
 - 1959 BATTERMAN VOL 4 PG 6 SHOWS E 1/4 COR SEC 36 4.49' NORTH OF W 1/4 COR SEC 31. REFERENCED BOTH.