U.S.

PUBLIC SURVEY LAND MONUMENT RECORD

For Public Land Survey Corners in: T. N., R. 4th P.M. CORNER CODE INDEX A1 2 3 4 5 6 7 8 9 10 11 12 13 14 15 16 17 18 19 2021 22 23 24 26 BC DEFINATION ON ABOVE INDEX PLACE MONUMENT SYMBOL AT PROPER LOCATION ON ABOVE INDEX	ROCK COUNTY, WI IF AVAILABLE ROCK COUNTY COORDINATES PERFERRED North 222,3/4,44 Elev. East 485,6(8,3/ Hor. Datum County Vert. Datum LATITUDE ELLIPS. HT LONGITUTE ELLIPS. HT LONGITUTE ELLIPS. DATUM NAD83(91) COUNTY LIST GPS (X) TRAVERSE (X) BASED ON THE FOLLOWING CONTROL:
(a) CORNER MONUMENT	

FIELD BOOK_ _PAGE # _ SHOW A PLAN VIEW DRAWING DEPICTING THE CORNER MONUMENT AND SURROUNDING PHYSICAL FEATURES, INCLUDING THE EXCAVATION AREA AND DEPTH. PLANNING & ZONING COMMITTEE ADOPTED THE ABOVE FORM ON 12/2/1982

BE549

(B) Describe any record evidence, monument evidence, occupational evidence, testimonial evidence or any other material evidence you considered, and whether the monument was found or placed.

```
NORTH BETWEEN SECTIONS 14 & 15
1834 HARRISON
     2640 QUARTER SEC CORNER IN PRAIRIE ON A POINT DESCENDING S.W. SET
          POST & RAISED A MOUND.
Α
     3432 LEAVE PRAIRIE & ENTER TIMBER
     3987.72
                HICKORY 8 IN DIAM.
                WHITE OAK 14 IN DIAM
     4303.86
                BUR OAK 12 IN DIAM
     5091.9
                SET CORNER TO SECS 10,11,14,15 (WHITE OAK 18 S44E 83.16
     5280
                BURR OAK 14 S62W 73.92', BURR OAK 10 N68E 56.76', RED OAK
               18 N73W 13.11'
                     NORTH BETWEEN SEC 10 & 11
                WHITE OAK 15 IN DIAM
     612.48
                QUARTER SEC CORNER {WHITE OAK 14 N29W 19.14', WHITE OAK
     2640
                12 S17W 33'
                WHITE OAK 12 IN DIAM
BROOK 6.6' CRS S.E. A FINE STREAM
     3207.6
     3528.36
                ALONG EAST LINE OF THE ENCAMPMENT OF GEN. ALEXANDER'S
     4455
                BRIGADE.
     4721.64
                BUR OAK 12 IN DIAM
                LEAVE TIMBER ENTER PRAIRIE & SET COR TO SECS 2,3,10,11
     5280
                {BURR OAK 18 S21E 143.88'; BURR OAK 18 S77E 195.36'
                     EAST ON RANDOM BETWEEN SECS 10 & 15
                TEMPY 1/4 SEC COR.
     2640
                LEAVE PRAIRIE & ENTER THICKET LEAVE THICKET & ENTER TIMBER
     3462.36
     4818
                INT EAST BOUNDARY 20.46 NORTH OF POST
     5244.36
```

COR. WEST SET POST & RAISED MOUND ON SMALL POINT CRS S.W.

5244.36 SEC COR.

1851 McVEAN VOL 1 PG 2 5244.36 TO SW COR SEC 10.

1866 LOCKE VOL 1 PG 262 FD STUMPS OF BTS & STAKE 2630.96 VAR 5-15 TO W 1/4 COR SEC 11.

1867 LOCKE VOL 1 PG 305 FD COR SET BY SELF VAR 5-15 FROM SW COR SEC 11 ALONG SOUTH LINE OF SEC 11. (RAN THIS LINE AT RIGHT ANGLES TO WEST LINE OF SEC) 2630.76 TO W 1/4 COR SEC 11.

1966 FD NAIL WHICH WAS SET OVER STONE MON. 2600.34 TO N 1/4 COR SEC 15

FD 2" PIPE 0.5' DEEP AT CENTER OF T INTERSECTION.

- C) Was the corner restored through acceptance of (1) an obliterated evidence location, or, (2) a found perpetuated location? ACCEPTED FOUND MONUMENT
- D) Describe any material discrepancy between the location of the corner as restored or reestablished and the location of that corner as previously restored or reestablished by distance and direction. Show the discrepancy on the plan view drawing under (a), above. Show the distances between the corner as previously restored or reestablished and (1) the corner as restored or reestablished, and (2) to at least 4 of the witness monuments shown on the drawing in (a), above.


(E) Was the corner reestablished through lost corner proportionate methods? If so, show the method, including the directions and distances to other public land survey corners used as evidence or used for proportioning the corner location.

I, Donald Barnes, hereby certify that the corner points as identified by the corner code index were, in a field survey on, established, re-established, monumented, re-monumented, recovered or restored as expressed below and in conformance with the regulations and rules as required in the current manual of survey instructions of the United States Department of Interior, Bureau of Land Management.

> COUNTY SURVEYOR FILING DATA Date of computer entry___ Date microfilmed __ Number of included sheets CORNER CODE

seal

A-E 7.08 REQUIREMENT

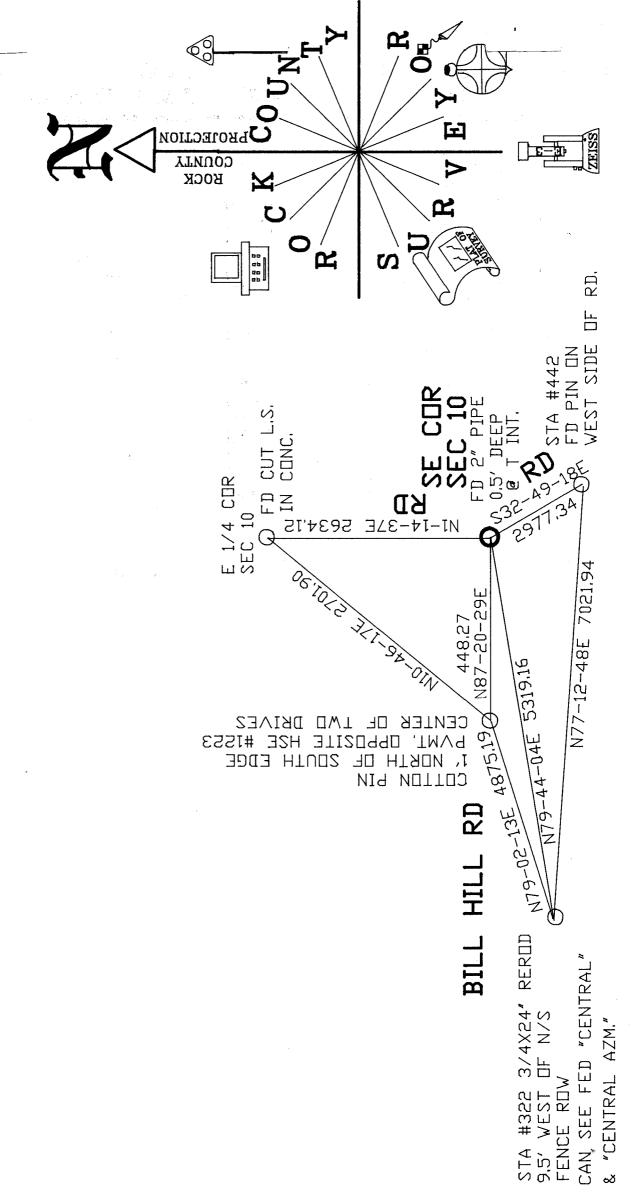

Donald Frances Oct 9, 1998

J-17