

U.S. PUBLIC LAND SURVEY MONUMENT RECORD

For Public Land Survey Corners in:

WI ADMINISTRATIVE CODE A-E 7.08 REQUIREMENT

T. 1 N., R. 12 E

CORNER CODE INDEX

BELOIT TWP
ROCK COUNTY WI

A	1	2	3	4	5	6	7	8	9	10	11	12	13	14	15	16	17	18	19	20	21	22	23	24	25
B																									
C	6																								
D																									
E																									
F	7																								
G																									
H																									
J																									
K	18																								
L																									
M																									
N																									
O																									
P	19																								
Q																									
R																									
S																									
T	30																								
U																									
V																									
W																									
X	31																								
Y																									
Z																									

IF AVAILABLE
ROCK COUNTY COORDINATES PREFERRED

North 211,862.29 Elev. _____

East 472,343.38

Hor. Datum Country Vert. Datum _____

LATITUDE _____ ELLIPS. HT. _____

LONGITUDE _____

GPS (X) _____ TRAVERSE (X) _____

BASED ON THE FOLLOWING CONTROL:

PLACE MONUMENT SYMBOL AT PROPER LOCATION ON ABOVE INDEX

CORNER MONUMENT

WITNESS MONUMENT

(a)

BEARINGS ARE BASED ON:

FIELD BOOK _____ PAGE # _____

SHEET 1 OF 2

SHOW A PLAN VIEW DRAWING DEPICTING THE CORNER MONUMENT AND SURROUNDING PHYSICAL FEATURES, INCLUDING THE EXCAVATION AREA AND DEPTH.

PLANNING & ZONING COMMITTEE ADOPTED THE ABOVE FORM ON 12/2/1982

CORNER CODE R-7

BE584

(B) Describe any record evidence, monument evidence, occupational evidence, testimonial evidence or any other material evidence you considered, and whether the monument was found or placed.

1834 HARRISON EAST ON RAND. BET. 20 & 29

2640 TEMPY 1/4 SEC. COR

4045.8 BROOK 5.28 CRS S.W.

5317.62 INT. E. BDY 10.56' NORTH OF POST
COR. WEST BET. 20 & 29

423.72' BURR OAK 12 IN. DIAM

1826.88 W.O. 12 IN DIAM

2658.81 QUARTER SEC COR
WHITE OAK 18 S71E 284.46'
RED OAK 8 N83E 33'

5317.62 SEC COR.

1859 RUGER VOL 1 PG 95 SURROUNDED BY 3 HH. BLACK OAK 6 S49-50W 55 1/4,
BLACK OAK 7 S62-05W 97, BLACK OAK 2 N37-55W 62.

1967 BATTERMAN VOL 4 PG 345 FD 2" PIPE SURROUNDED BY HH. SET MON BOX
OVER 1" PIPE & REFERENCED SAME.

1981 BARNES VOL 6 PG 213 FOUND MON BOX WITH 1" PIPE.

FOUND 1" PIPE IN MON. BOX.

C) Was the corner restored through acceptance of (1) an obliterated evidence location, or, (2) a found perpetuated location?
ACCEPTED FOUND PERPETUATED LOCATION.

D) Describe any material discrepancy between the location of the corner as restored or reestablished and the location of that corner as previously restored or reestablished by distance and direction. Show the discrepancy on the plan view drawing under (a), above. Show the distances between the corner as previously restored or reestablished and (1) the corner as restored or reestablished, and (2) to at least 4 of the witness monuments shown on the drawing in (a), above.

(E) Was the corner reestablished through lost corner proportionate methods? If so, show the method, including the directions and distances to other public land survey corners used as evidence or used for proportioning the corner location.

NO

I, Donald Barnes, hereby certify that the corner points as identified by the corner code index were, in a field survey on, established, re-established, monumented, re-monumented, recovered or restored as expressed below and in conformance with the regulations and rules as required in the current manual of survey instructions of the United States Department of Interior, Bureau of Land Management.

MISSOURI
seal
Donald Barnes
Oct 16, 1998

EMBOSS LAND SURVEYOR SEAL

COUNTY SURVEYOR FILING DATA

Date of computer entry _____

Date microfilmed _____

Number of included sheets _____

CORNER CODE

A-E 7.08 REQUIREMENT

R-7

Donald Barnes
Oct 16, 1998

W 1/4 COR
SEC 20
FD DISK IN
CONC. MON.

E 1/4 COR
SEC 20
FD DISK
IN CONC. MON.

S89-05-32E 5361.28

S44-46-00E 3793.31

N45-52-35E 3746.33

N26-08-54E 2921.70

S89-07-38E 742.70

STA #219 FD R/R
WITH CUT X
DRILLED HOLE IN X
2 SOUTH CENTER PVMT,
OPPOSITE WEST EDGE
GRAVEL DR TO HSE
#4212


FD 1" PIPE
IN MON. BOX

**S 1/4 COR
SEC 20**

S89-24-33E 1401.76

STA #220 3/4X24 RERODD
1.9 NORTH OF NORTH PVMT
EDGEJ91 +/- WEST OF
LARGE CMP.

SPRING CREEK RD

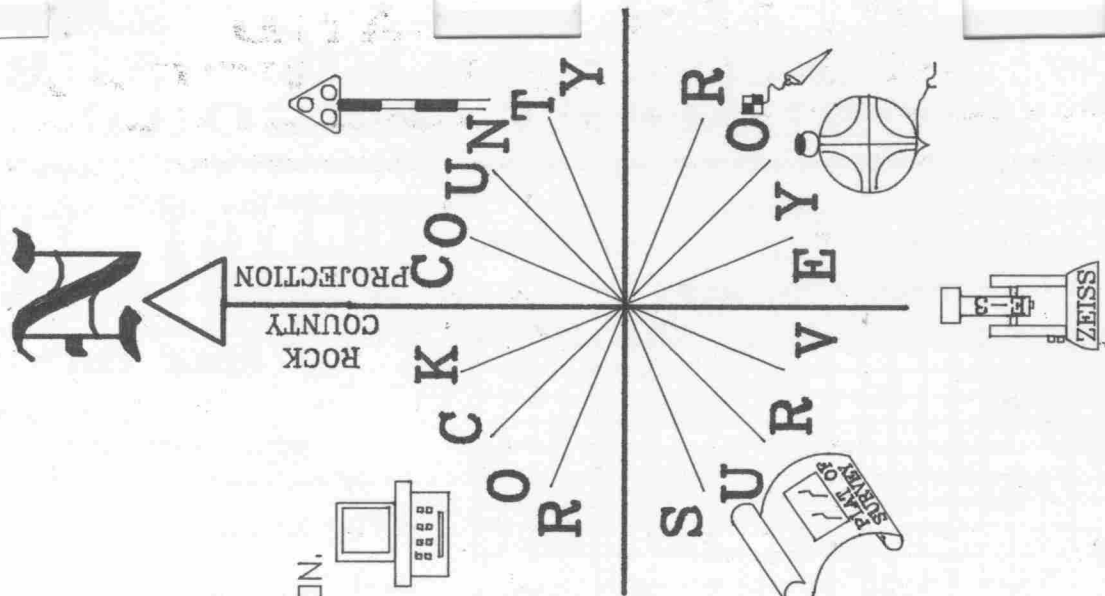

R-7