

PUBLIC LAND SURVEY MONUMENT RECORD

For Public Land Survey Corners in the


T. 1 N., R. 13 E.

CORNER CODE INDEX

	1	2	3	4	5	6
A						
B	6	5	4	3	2	
C						
D						
E						
F	7	6	5	4	3	2
G						
H						
I						
J	8	7	6	5	4	3
K						
L						
M						
N						
O	9	8	7	6	5	4
P						
Q						
R						
S	10	9	8	7	6	5
T						
U						
V						
W	11	10	9	8	7	6
X						
Y						
Z						

PLACE MONUMENT SYMBOL (●) AT PROPER LOCATION ON ABOVE INDEX

EXAMPLE

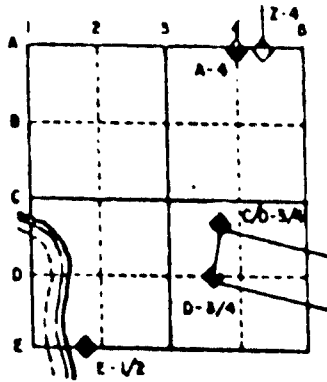

TURTLE TWP  
ROCK COUNTY WI

IF AVAILABLE  
STATE PLANE COORDINATES

North (Y) 206,298.16 Elev. (Z) \_\_\_\_\_

East (X) 196,244.95 Zone \_\_\_\_\_

Hor. Datum COUNTY Vert. Datum \_\_\_\_\_

◆ CORNER MONUMENT

○ WITNESS MONUMENT

Fd 1" PIN IN  
MON BOX.

Fd TIES IN V25 (BECOIT TWP)

BEARINGS ARE BASED ON:

(B) Describe any record evidence, monument evidence, occupational evidence, testimonial evidence or any other material evidence you considered, and whether the monument was found or placed.

- 1859 HOBART VOL 1 PG 107. STATES NOTHING ABOUT CORNER. SHOWS A DISTANCE OF 343.53 TO THE CENTER OF MILWAUKEE AND A BEARING OF S89-58E TO THE SOUTH QUARTER CORNER OF SECTION 30. HE SHOWS A BEARING OF N51-33E FOR THE CENTER OF MILWAUKEE ROAD.
- 1885 RUGER VOL 2 PG 295 HE SHOWS A DISTANCE OF 344.39 TO THE CENTER OF MILWAUKEE. STATES NOTHING ABOUT THE CORNER.
- 1919 BATTERMAN VOL 3 PG 74. FOUND LIMESTONE WITH DRILL HOLE AT SECTION CORNER. HIS MAP SHOWS IT ON THE EAST SIDE OF THE ROAD.
- 1957 SHIMEAL. PLAT OF SURVEY. SHOWS A STONE AT THE NW COR SEC 31 WITH PIN AND MONUMENT BOX ON TOP. HE ALSO SHOWS A DISTANCE OF 1320.65 TO THE 1/16TH CORNER TO THE SOUTH.
- 1989 BARNES V25 BELOIT TWP. FOUND A 1" PIN IN ROUND MONUMENT BOX IN HEDGE ROW BETWEEN HOUSES #1151 AND #1141. CORNER IS 24.8 EAST OF THE CENTER OF THE PAVEMENT.

FOUND MONUMENT BOX & REFERENCE PIPES.

C) Was the corner restored through acceptance of (1) an obliterated evidence location, or, (2) a found perpetuated location?

ACCEPTED FOUND PERPETUATED LOCATION

D) Describe any material discrepancy between the location of the corner as restored or reestablished and the location of that corner as previously restored or reestablished by distance and direction. Show the discrepancy on the plan view drawing under (a), above. Show the distances between the corner as previously restored or reestablished and (1) the corner as restored or reestablished, and (2) to at least 4 of the witness monuments shown on the drawing in (a), above.

(E) Was the corner reestablished through lost corner proportionate methods? If so, show the method, including the directions and distances to other public land survey corners used as evidence or used for proportioning the corner location.

NO

I, Donald Barnes, hereby certify that the corner points as identified by the corner code index were, in a field survey on, 1995, established, re-established, monumented, re-monumented, recovered or restored as expressed below and in conformance with the regulations and rules as required in the current manual of survey instructions of the United States Department of Interior, Bureau of Land Management.

COUNTY SURVEYOR FILING DATA

seal

Date of computer entry \_\_\_\_\_

Date microfilmed \_\_\_\_\_

Number of included sheets \_\_\_\_\_

CORNER CODE

EMBOSS LAND SURVEYOR SEAL

A-E 7.08 REQUIREMENT

V /