

U.S. PUBLIC LAND SURVEY MONUMENT RECORD

For Public Land Survey Corners in the


T. 1 N., R. 13 E.

CORNER CODE INDEX

	1	2	3	4	5	6	7	8	9	10	11	12	13	14	15	16	17	18	19	20	21	22	23	24	25
A																									
B																									
C																									
D																									
E																									
F																									
G																									
H																									
I																									
J																									
K																									
L																									
M																									
N																									
O																									
P																									
Q																									
R																									
S																									
T																									
U																									
V																									
W																									
X																									
Y																									
Z																									

PLACE MONUMENT SYMBOL (◆) AT PROPER LOCATION ON ABOVE INDEX

EXAMPLE

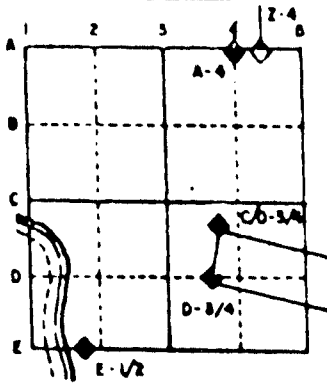

TURTLE TWP
ROCK COUNTY WI

IF AVAILABLE
STATE PLANE COORDINATES

North (Y) 200,953.46 Elev. (Z) _____
 East (X) 504,129.54 Zone _____
 Hor. Datum COUNTY Vert. Datum _____

◆ CORNER MONUMENT

○ WITNESS MONUMENT

BEARINGS ARE BASED ON:

(B) Describe any record evidence, monument evidence, occupational evidence, testimonial evidence or any other material evidence you considered, and whether the monument was found or placed.

1834 LYONS SET A POST AND RAISED A CIRCULAR MOUND OF EARTH FOR 1/4 SECTION CORNER ON BLACK SANDY PRAIRIE.

1973 SHIMEALL MAP #5008 CALLS FOR 1330.0 FROM SE COR TO S 1/16TH COR OF SE 1/4 OF SECTION 32.

1991 KREBS MAP #11598 CALLS FOR 1330.0 FROM SE COR TO S 1/16TH COR OF 1/4 OF SECTION 32, 1994.31' TO ILL. CLOSING CORNER TO THE EAST, AND AN ANGLE OF 179-51-02 AT THE SW COR SEC 33 FROM S 1/4 COR SEC 33 TO ILL. CLOSING CORNER. SHOWS ILL. CLOSING CORNER (NE COR SEC 3) IS 664.31' WEST OF S 1/16TH COR OS SE 1/4 COR SEC 32.

FOUND 1/2"X18" PIN AT FENCE INT. REPLACED WITH PLY MON. PLACED CARSONITE POST ON EAST SIDE. FOUND S 1/16TH COR OF THE SE 1/4 OF SEC 32 AND THE NW COR SEC 2 T46N R2E WHICH ARE IN HARMONY WITH THE PIN. 1994.25 FROM SE COR TO NE COR SEC 3 & 664.29 FROM NE COR SEC 3 TO S 1/16TH COR OF THE SE 1/4 OF SEC 32.

C) Was the corner restored through acceptance of (1) an obliterated evidence location, or, (2) a found perpetuated location?

D) Describe any material discrepancy between the location of the corner as restored or reestablished and the location of that corner as previously restored or reestablished by distance and direction. Show the discrepancy on the plan view drawing under (a), above. Show the distances between the corner as previously restored or reestablished and (1) the corner as restored or reestablished, and (2) to at least 4 of the witness monuments shown on the drawing in (a), above.

(E) Was the corner reestablished through lost corner proportionate methods? If so, show the method, including the directions and distances to other public land survey corners used as evidence or used for proportioning the corner location.

NO

I, Donald Barnes, hereby certify that the corner points as identified by the corner code index were, in a field survey on, OCT 10, 1994, established, re-established, monumented, re-monumented, recovered or restored as expressed below and in conformance with the regulations and rules as required in the current manual of survey instructions of the United States Department of Interior, Bureau of Land Management.

COUNTY SURVEYOR FILING DATA

Date of computer entry _____

Date microfilmed _____

Number of included sheets 1
CORNER CODE


seal

Donald Barnes
3/10/95


EMBOSS LAND SURVEYOR SEAL

N


COUNTY SYSTEM

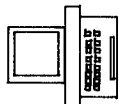

C O R
C K C O U N T Y

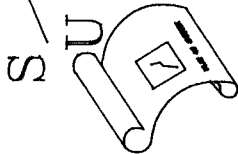

S U R V E Y
O R

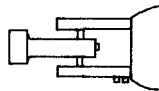

10

9' NORTH OF NORTH EDGE
OF PVMT. & 5' EAST OF WEST
EDGE OF GRAVEL FARM ENT.

STA #999

CTH "P"

XXXXXXXXXXXXXXXXXXXX
NO-10-58W 554.14

S56-36-57E 41.17
N88-31-21E 44.23
N84-00-20E 30.37
N88-31-21E 44.23
N84-00-20E 30.37

FD BRASS
PLUG IN
CONC. MON.
PLACED CARSONITE

SW COR
SEC 32

S89-02-05E 2652.74

XXXXXXXXXXXXXXXXXXXX
1/16th COR

S88-57-12E 1329.95

FD 1" PIN

XXXXXXXXXXXXXXXXXXXX

XXXXXXXXXXXXXXXXXXXX
MONUMENT IS 0.1' NORTH
OF FENCE INT. & 0.4' EAST OF
FENCE INT.
PLACE CARSONITE POST
ON EAST SIDE OF MONUMENT.

N89-32-18W 2642.46

SW COR
SEC 32

PIN AT 1/16TH COR IS
ON LINE WITH THE NW COR SEC 2 AND THE SE COR
OF SEC 32. IT IS 1.89' NORTH OF A
LINE BETWEEN THE S 1/4 COR & SE CORNERS OF
SEC 32.

NW COR SEC 2
T462 R2E

Donald Barnes
3/10/95