

U.S. PUBLIC LAND SURVEY MONUMENT RECORD


For Public Land Survey Corners in the
T. 1 N., R. 13 E.

CORNER CODE INDEX

	1	2	3	4	5	6	7	8	9	10	11	12	13	14	15	16	17	18	19	20	21	22	23	24	25
A																									
B																									
C	8																								
D		5																							
E			4																						
F				3																					
G																									
H	7																								
I		6																							
J			5																						
K				4																					
L	18																								
M		17																							
N			16																						
O				15																					
P					14																				
Q						13																			
R							12																		
S								11																	
T									10																
U										9															
V											8														
W												7													
X													6												
Y														5											
Z															4										
1																3									
2																	2								
3																		1							
4																									
5																									
PLACE MONUMENT SYMBOL (◆) AT PROPER LOCATION ON ABOVE INDEX

EXAMPLE

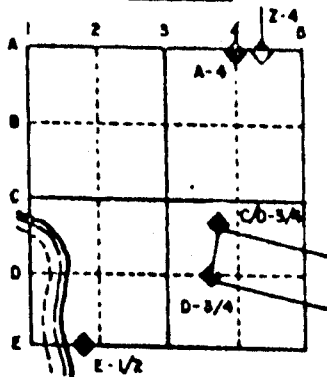

TURTLE TWP
ROCK COUNTY WI

IF AVAILABLE
STATE PLANE COORDINATES

North (Y) 200,678.15 Eleve. (Z) _____


East (X) 517,351.04 Zone _____

Hor. Datum COUNTY Vert. Datum _____

◆ CORNER MONUMENT

○ WITNESS MONUMENT

BEARINGS ARE BASED ON: ASSUMED

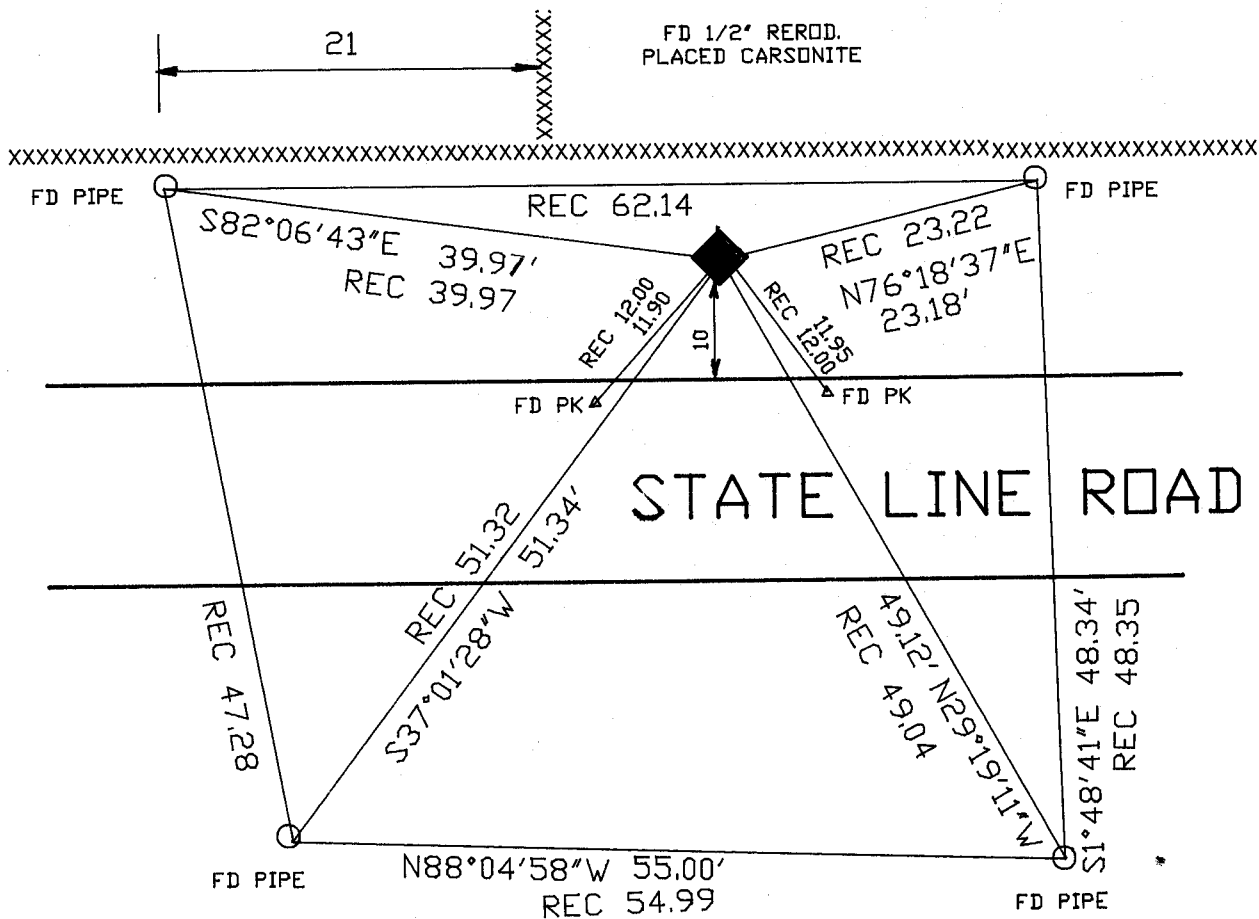

MICROFILMED

SHEET ___ OF ___

CORNER CODE: 217

(B) Describe any record evidence, monument evidence, occupational evidence, testimonial evidence or any other material evidence you considered, and whether the monument was found or placed.

1833 LYONS ORIGINAL SURVEY. SET A POST ON A RIDGE RUNNING E & W FOR CORNER TO SEC 34 & 25. BUR OAK 20 N65W 90.42; BUR OAK 18 N48E 186.78. CALLS FOR 2640 TO S 1/4 CORNER OF SECTIONS 34 & 35.

1978 BARNES VOL 5 PG 461 DUG & FOUND NOTHING. INSTALLED ALUMINUM MONUMENT 1' DEEP ON LINE WITH NE CORNER SEC 1 T46N R2E AND S 1/4 CORNER OF SECTION 36 AT SINGLE PROPORTIONATE DISTANCE.

1978 BARNES VOL 5 PG 456 CALLS FOR 1788.05 TO NE CORNER OF SECTION 1 T46N R2E AND 2642.90.

FOUND REROD THAT THE R.H. BATTERMAN COMPANY INSTALLED FROM TIES A FEW WEEKS AGO.



C) Was the corner restored through acceptance of (1) an obliterated evidence location, or, (2) a found perpetuated location?

ACCEPTED FOUND PERPETUATED LOCATION. DID NOT SEARCH FOR ALUMINUM MONUMENT.

D) Describe any material discrepancy between the location of the corner as restored or reestablished and the location of that corner as previously restored or reestablished by distance and direction. Show the discrepancy on the plan view drawing under (a), above. Show the distances between the corner as previously restored or reestablished and (1) the corner as restored or reestablished, and (2) to at least 4 of the witness monuments shown on the drawing in (a), above.

(E) Was the corner reestablished through lost corner proportionate methods? If so, show the method, including the directions and distances to other public land survey corners used as evidence or used for proportioning the corner location.

I, Donald Barnes, hereby certify that the corner points as identified by the corner code index were, in a field survey on, Nov 20 1991, established, re-established, monumented, re-monumented, recovered or restored as expressed below and in conformance with the regulations and rules as required in the current manual of survey instructions of the United States Department of Interior, Bureau of Land Management.

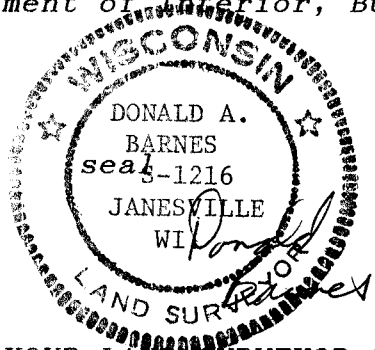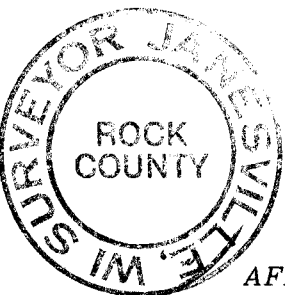

AFFIX YOUR LAND SURVEYOR SEAL

COUNTY SURVEYOR FILING DATA

Date of computer entry _____

Date microfilmed _____

Number of included sheets _____
CORNER CODE