

U.S. PUBLIC LAND SURVEY MONUMENT RECORD

For Public Land Survey Corners in:

WI ADMINISTRATIVE CODE A-E 7.08 REQUIREMENT

T. 1N., R. 12E 4th P.M.

CORNER CODE INDEX

A	1	2	3	4	5	6	7	8	9	10	11	12	13	14	15	16	17	18	19	20	21	22	23	24	25
B	6	5	4	3	2	1																			
C	7	8	9	10	11	12																			
D	18	17	16	15	14	13																			
E	19	20	21	22	23	24																			
F	30	29	28	27	26	25																			
G	31	32	33	34	35	36																			

BELOIT TWP
ROCK COUNTY, WI

IF AVAILABLE
ROCK COUNTY COORDINATES PREFERRED

North 233,316.01 Elev. _____

East 464,646.09

Hor. Datum COUNTRY Vert. Datum _____

LATITUDE _____ ELLIPS. HT. _____

LONGITUDE _____

ELLIPS. DATUM
NAD83(91) _____ COUNTY _____ LIST _____

GPS (X) _____ TRAVERSE (X) _____

BASED ON THE FOLLOWING CONTROL:

PLACE MONUMENT SYMBOL \blacklozenge AT PROPER LOCATION ON ABOVE INDEX

\blacklozenge CORNER MONUMENT

WITNESS MONUMENT

(a)

BEARINGS ARE BASED ON:

ALSO SEE
E-1 TIES
FOR
ROCK TWP
REFERENCE

FIELD BOOK _____ PAGE # _____

SHEET 1 OF 2

SHOW A PLAN VIEW DRAWING DEPICTING THE CORNER MONUMENT AND SURROUNDING PHYSICAL FEATURES, INCLUDING THE EXCAVATION AREA AND DEPTH.

PLANNING & ZONING COMMITTEE ADOPTED THE ABOVE FORM ON 12/2/1982

CORNER CODE H-1

BE501

(B) Describe any record evidence, monument evidence, occupational evidence, testimonial evidence or any other material evidence you considered, and whether the monument was found or placed.

- 1833 MULLETT ORIGINAL GOVERNMENT SURVEYOR. FIELD NOTES - SET POST CORNERS TOWNSHIP 1 & 2 N. RANGES 11 & 12 E BLACK OAK 8 N53E .30 AND BLACK OAK 6 S32E .14
- 1833 ORIG PLAT CALLS FOR 2640 TO THE E 1/4 COR SEC 1.
- 1868 LOCKE PLYMOUTH TOWNSHIP REMONUMENTATION FIELD NOTES. SOUTH ON EAST LINE OF SECTION 36. INTERSECTED SOUTH BOUNDARY 5.61' WEST OF CORNER. FOUND STUMPS OF B.T.s AND OLD STAKE. VAR CORRECTED 7-32. MEASURED 2661.12' TO NE CORNER OF SECTION 36 FROM E 1/4 CORNER OF SECTION 36 PLYMOUTH TOWNSHIP AND 2645.45 TO S 1/4 CORNER OF SECTION 36.
- 1870 RUGER VOL 2 PG 45. FOUND STONE MONUMENT SET BY LOCKE. SHOWS 2446.84 TO THE N 1/4 CORNER OF SECTION 6 BELOIT.
- 1871 COLLINS - NEWARK REMONUMENTATION FIELD NOTES. NORTH ON EAST LINE OF 1 VARIATION 5-45
 - 2655.18 INTERSECTED 1/4 LINE 10.56' EAST OF CORNER. SET 1/4 STONE BY STUMPS OF WITNESS TREES. CORRECTED VARIATION 5-30. CONTINUED NORTH VARIATION 5-15
 - 5312.34 INTERSECTED TOWN LINE 7.26' EAST OF STONE SET FOR SE CORNER. SEC 36 T2 R11 AGREEING WITH WITNESS TREES CORRECTED VARIATION 5-05. OCT 13, 1871
 - EAST ON NORTH LINE SEC 1 ON OFFSET 12.54 NORTH VARIATION 5-15.
 - 2584.56 OFFSET 33' SOUTH AND CONTINUED EAST WITH VARIATION 6
 - 5216.64 INTERSECTED RANGE LINE 19.8' SOUTH OF CORNER. WEST CORRECTED BACK VARIATION 5-17
 - 2608.32 SET 1/4 36.3' EAST OF PLYMOUTH 1/4 CORNER. CONTINUED WEST VARIATION 5-17
 - 5216.64 SECTION CORNER. OCT 18, 1871
- 1874 RUGER VOL 2 PG 127 STONE MONUMENT.
- 1881 LEE VOL 2 PG 328 FOUND MONUMENT SHOWS 2448.60 TO N 1/4 CORNER OF SECTION 6 BELOIT TOWNSHIP AND 2647.92 TO W 1/4 CORNER OF SECTION 6.
- 1959 BATTERMAN VOL 4 PG 11 FOUND CUT LIMESTONE. 1" PIPE IN BLACKTOP. WPL COORDINATES N/S 214,300.60 E/W 2,234,552.50. REFERENCED CORNER.
- 1966 BATTERMAN VOL 4 PG 286 IRON PIPE
- 1981 BARNES VOL 6 PG 144 SHOWS THE FOLLOWING DISTANCES:

TO W 1/4 COR SEC 31	WPL N1-26N02W	2647.01
	LOCKE 1868	2650.56
	RUGER 1870	2641.98
S 1/4 COR SEC 31	RUGER 1870	2651.22
N 1/4 COR SEC 6	RUGER 1870	2446.84
	WPL N89-38-22E	2452.66
W 1/4 COR SEC 6	WPL N0-01-26W	2650.74
	COLLINS 1871	2657.16

FOUND 3/4" PIPE THAT IS 2' EAST OF THE CENTER OF THE PAVEMENT.

C) Was the corner restored through acceptance of (1) an obliterated evidence location, or, (2) a found perpetuated location?

ACCEPTED FOUND PERPETUATED LOCATION.

I, Donald Barnes, hereby certify that the corner points as identified by the corner code index were, in a field survey on, August 17, 1990, established, re-established, monumented, re-monumented, recovered or restored as expressed below and in conformance with the regulations and rules as required in the current manual of survey instructions of the United States Department of Interior, Bureau of Land Management.

Donald Barnes
OCT 9, 1998

Number of included sheets _____

AFFIX YOUR LAND SURVEYOR SEAL

CORNER CODE

A-1

NW COR
SEC 6

FD 3/4 PIPE
2' EAST OF CENTER
OF PAVEMENT

S89-43-21E 2453.06

N 1/4 COR
SEC 6
FD ALUM. MON.

S43-23-22E 3902.51

S60-58-56E 5870.86

S0-03-06E 4129.84

S0-36-20W 2650.86

JOHNSON RD

NO E/W FENCES

FD 1" PIPE


E 1/4 COR
SEC 1

S1-13-45E
1479.46

N75-58-10E
5287.91

FD ALUM MON.

1/4 COR
SEC 6

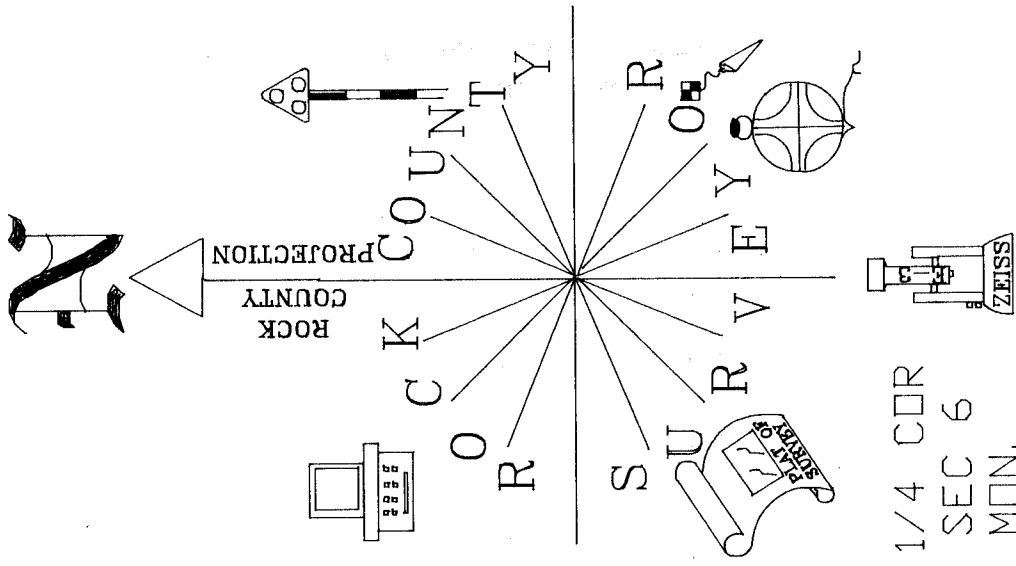

STA 492(GPS)
3/4X24 REROD
ON NARROW N/S RIDGE
EAST SIDE PVMT

OBSERVATION SHEET 501
BELOIT TWP PROJECT

Donald Barnes
OCT 9, 1998

A-1